

# UPPER EAST SIDE - NEW YORK, NY

# 1,125 RSF

## OFFICE / OPEN AREA SPACE FOR LEASE



## AGORA BUILDING

1556 THIRD AVENUE / 177 E 87TH STREET

### Availability

**Suite 601A: 1,125 RSF**

### Comments

- Windows Facing 87<sup>th</sup> Street (South)
- Open Space
- High Ceiling
- Tenant Controlled Central A/C

### Property

**Built: 1915**

**Renovated: 2023**

**Stories: 6**

**Gross Building Area: 78,179 SF**

### Building Notes

**Only First Class Office Building of the Upper East Side.  
2 Building Entrances & Lobbies on Third Ave. & E 87th St.  
Weekday Lobby Concierge until 9pm.**

### **Subway Accessibility:**

**4,5,6 Lines: One Block West**

**Q Line: One Block East**

### Building Tenants

- Professional Physical Therapy
- Icahn School of Medicine at Mount Sinai
- SLT
- Loftlinks
- Barnes & Noble

# UPPER EAST SIDE - NEW YORK, NY

# 1,125 RSF



## OFFICE / OPEN AREA

## SPACE FOR LEASE

### Area Map



### Floor Plan

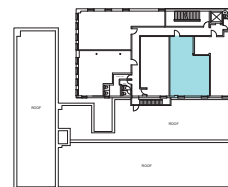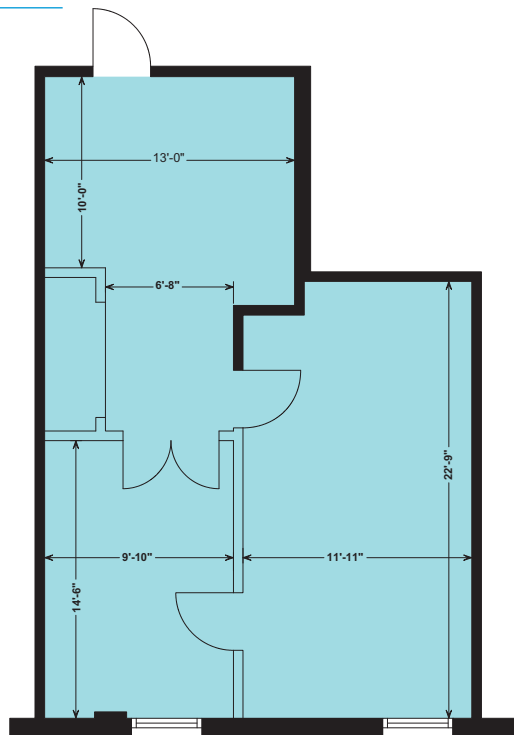

Key Plan: Not to Scale

Suite 601A - 1,125 RSF  
(As Built)