


Key Plan: Not to Scale



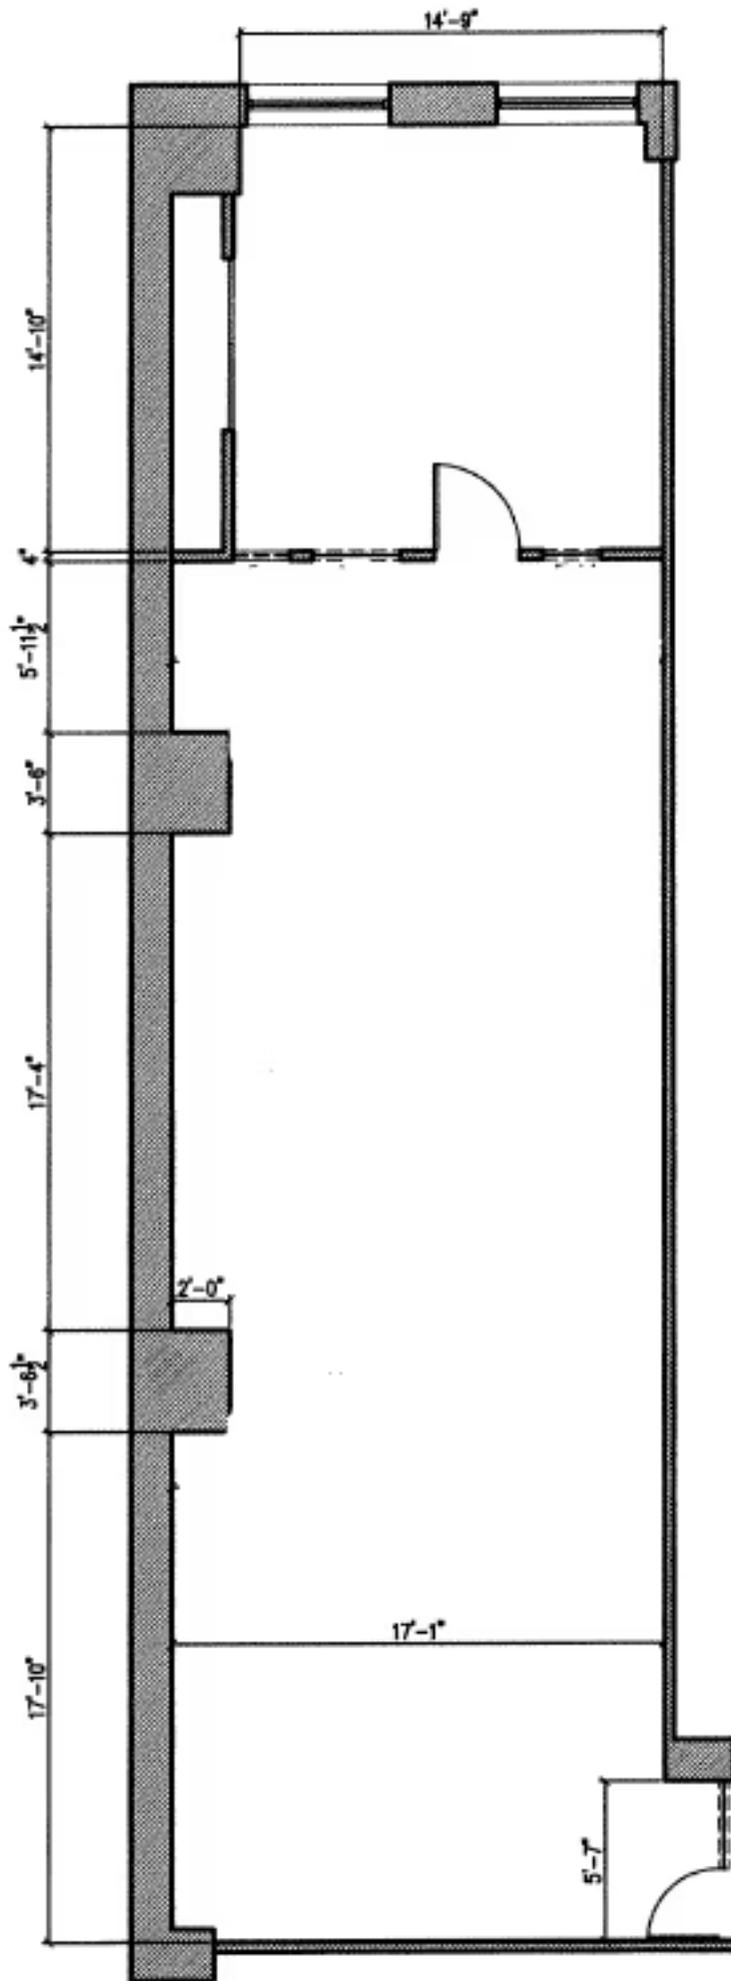

PROJECT: SUITE 608 530 7TH AVENUE		A01
TITLE: AS BUILT	PROJ. No. 00919	
SCALE: 1/8"=1'-0"	DATE: 5/23/13	