


-- ALL DIMENSIONS AND CONDITIONS ARE --
APPROXIMATE AND SUBJECT TO FIELD VERIFICATION

7TH FLOOR
PROPOSED PLAN

DATE: MAY 14, 2025
DWG. NO.: TF-01

60 MADISON AVENUE
NEW YORK, NY

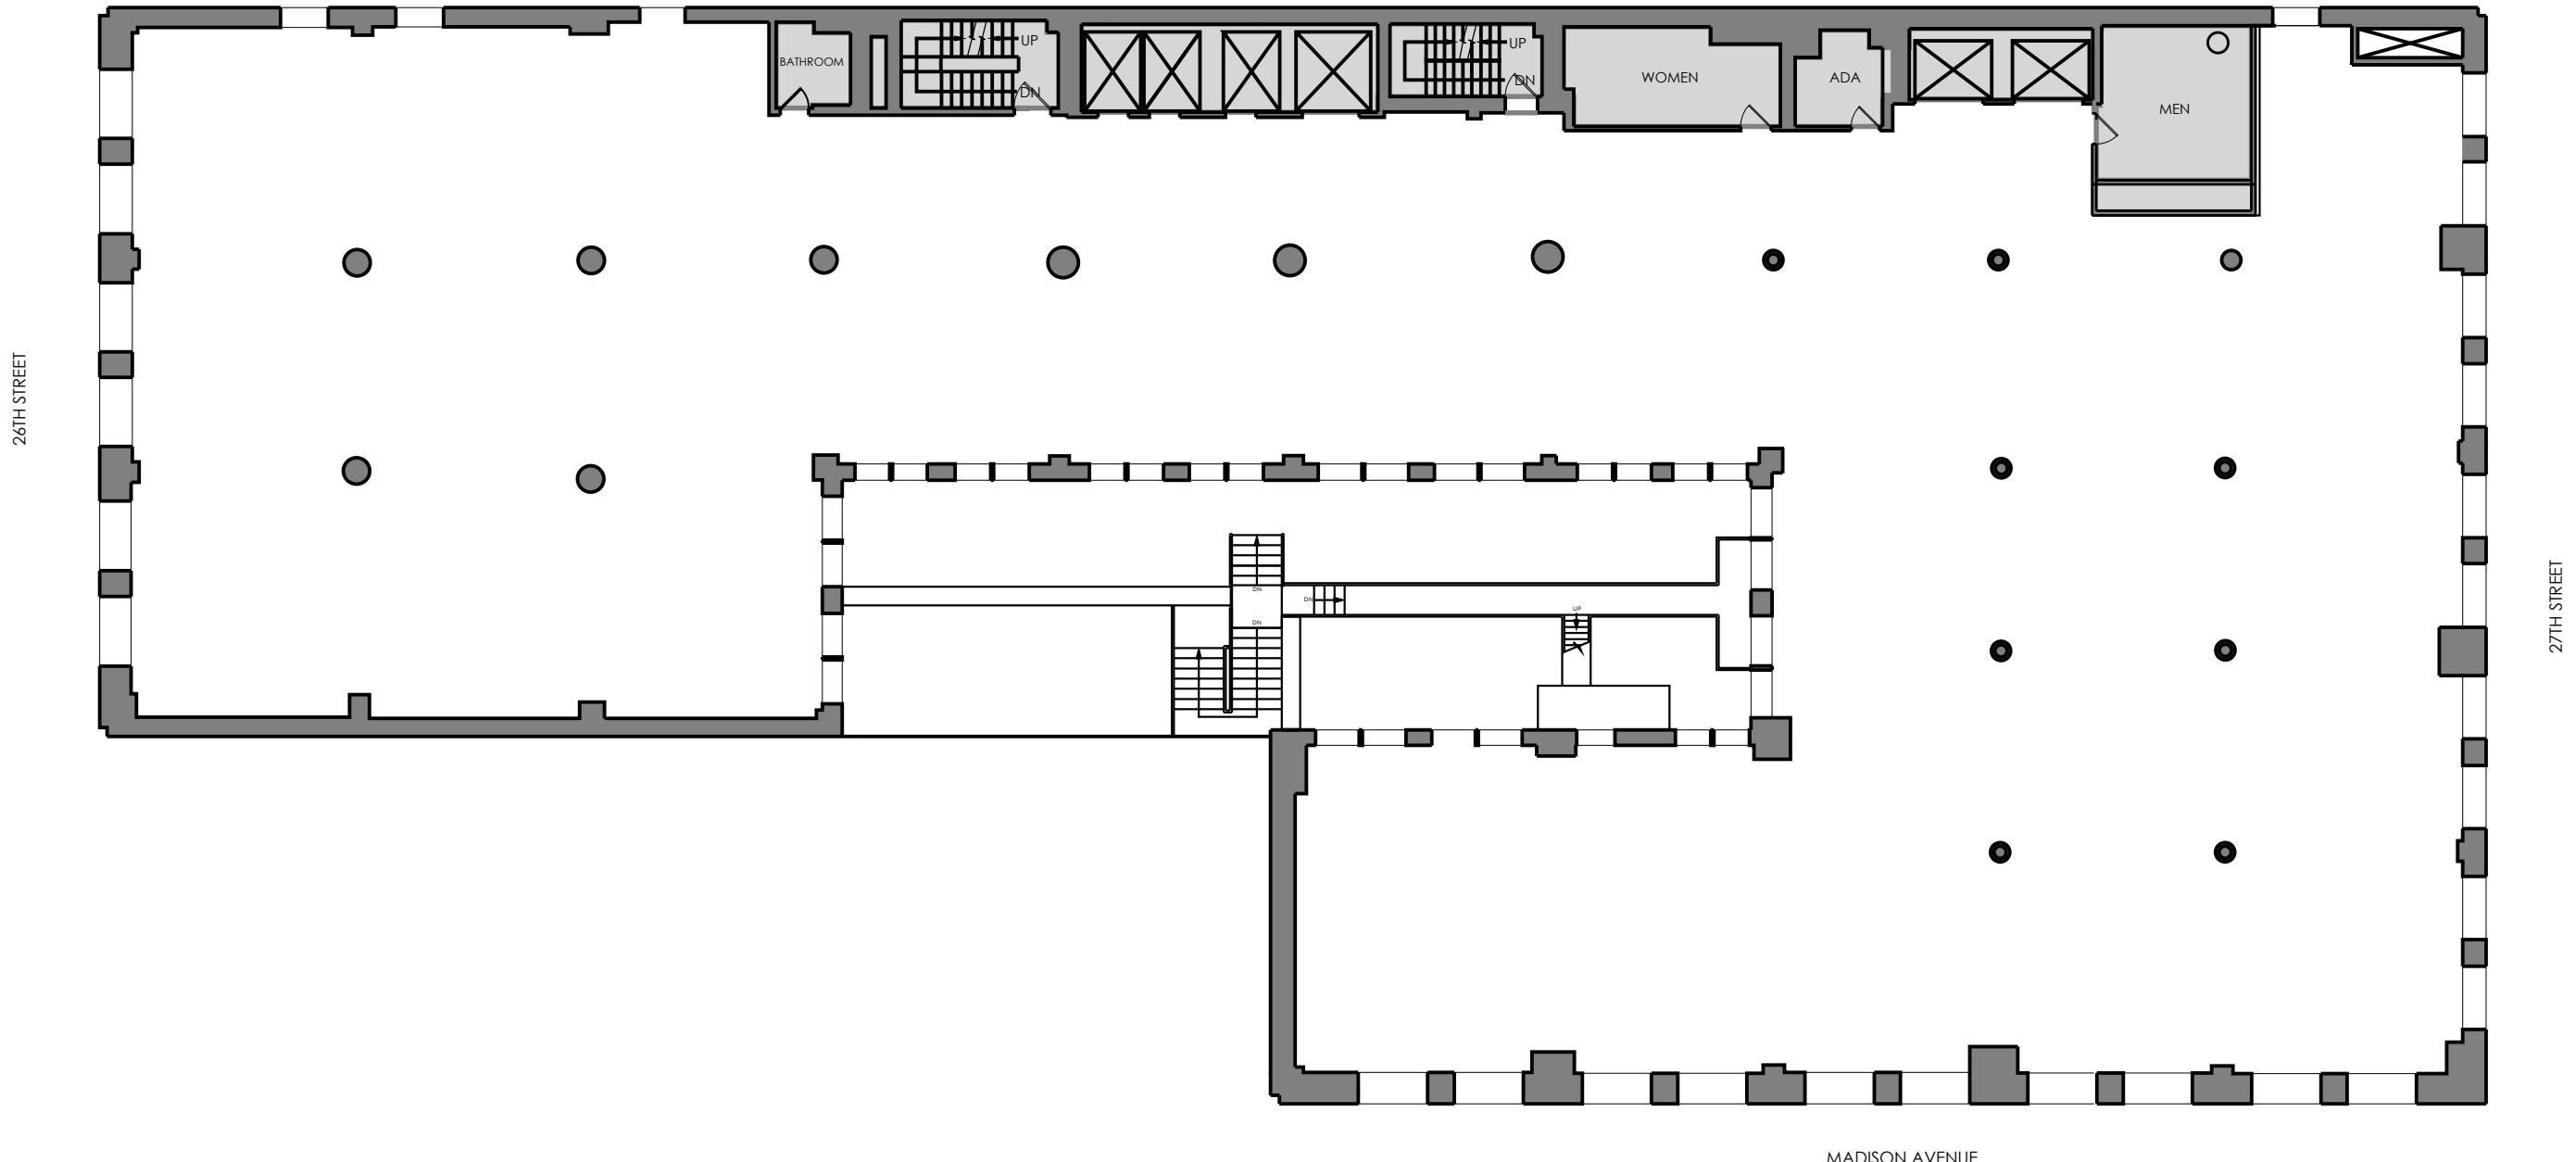


-- ALL DIMENSIONS AND CONDITIONS ARE --
APPROXIMATE AND SUBJECT TO FIELD VERIFICATION

7TH FLOOR - CORE & SHELL

REVISION: -
DATE: 07.12.23
DWG. NO.: TF-01

60 MADISON AVENUE
NEW YORK, NY

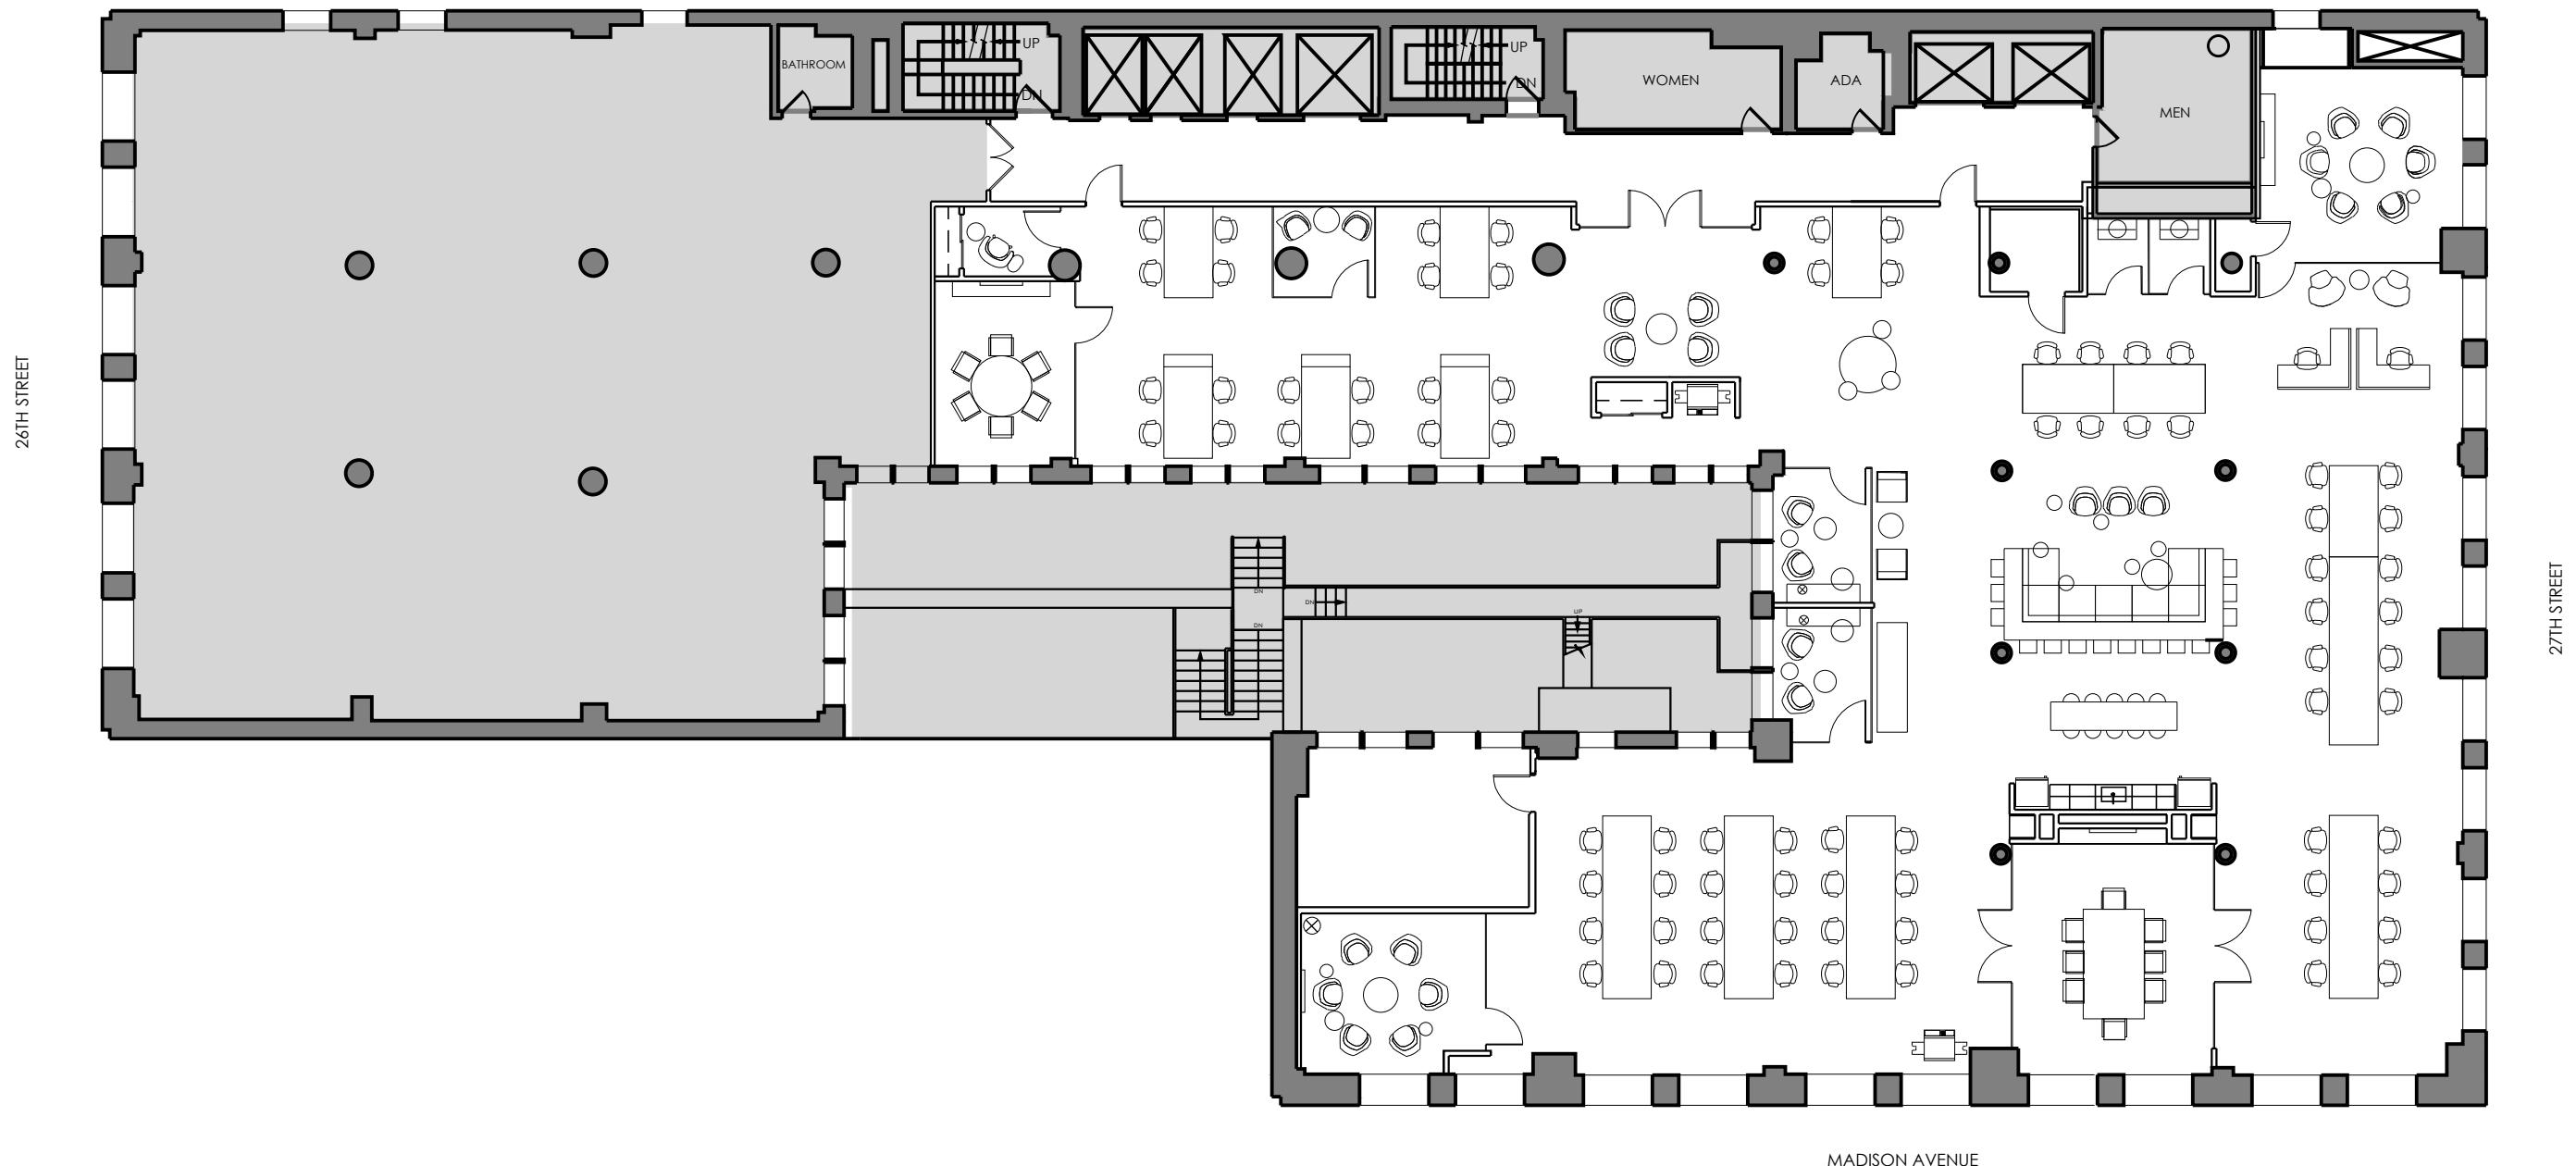


-- ALL DIMENSIONS AND CONDITIONS ARE --
APPROXIMATE AND SUBJECT TO FIELD VERIFICATION

7TH FLOOR - AS BUILT

REVISION: -
DATE: 07.12.23
DWG. NO.: TF-02

60 MADISON AVENUE
NEW YORK, NY

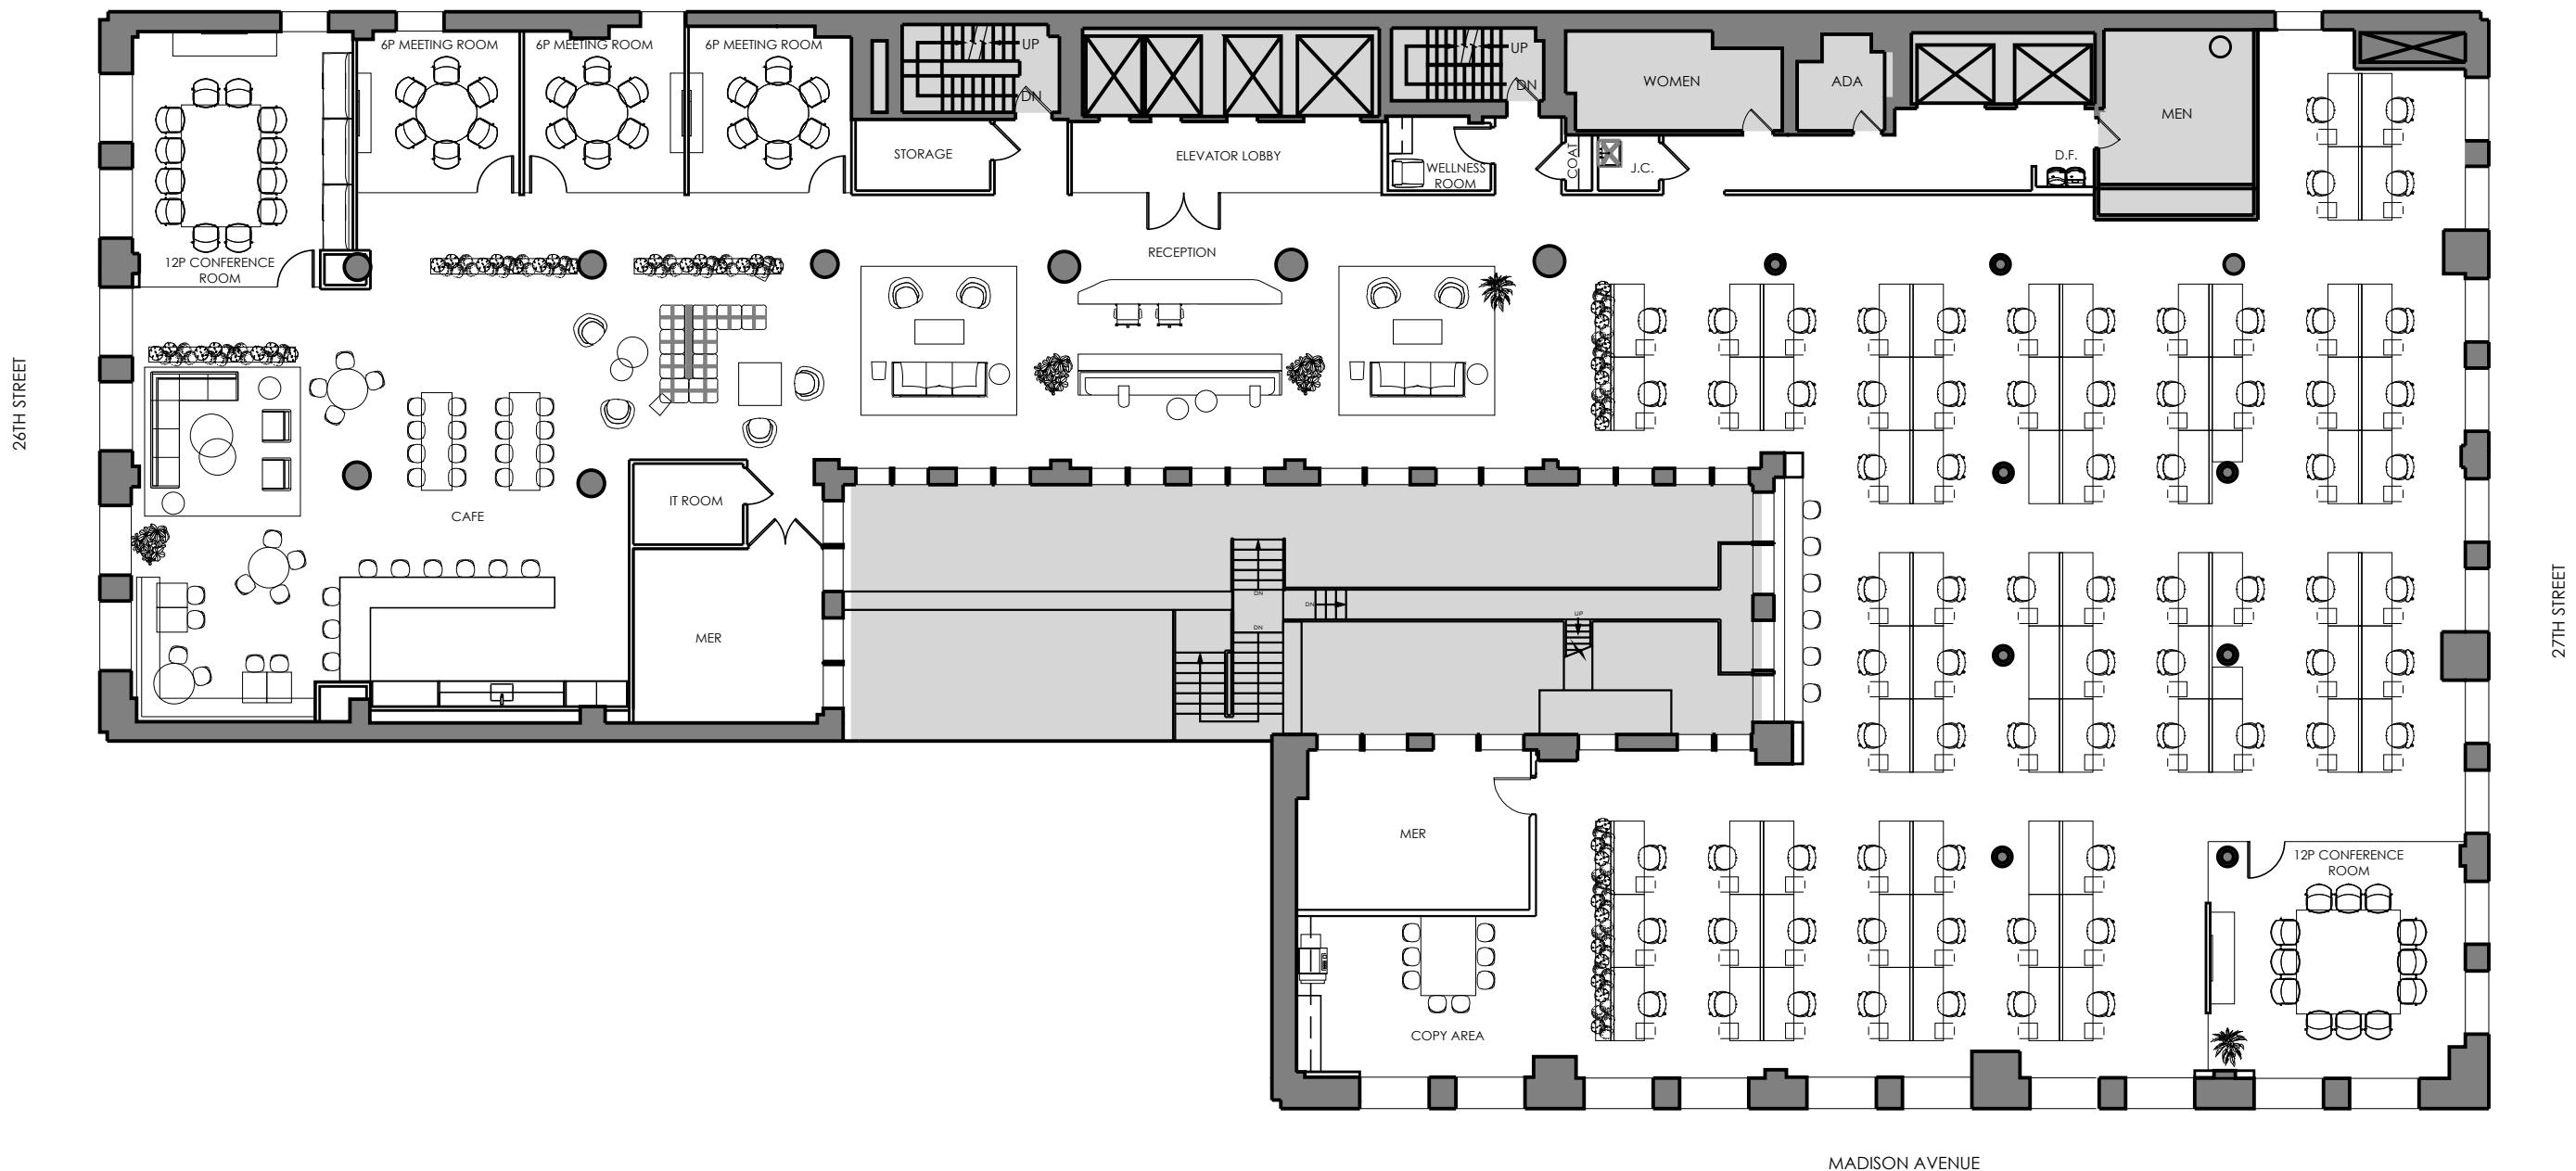

-- ALL DIMENSIONS AND CONDITIONS ARE --
APPROXIMATE AND SUBJECT TO FIELD VERIFICATION

7TH FLOOR - TEST FIT

REVISION: -
DATE: 07.12.23
DWG. NO.: TF-03

60 MADISON AVENUE
NEW YORK, NY

