


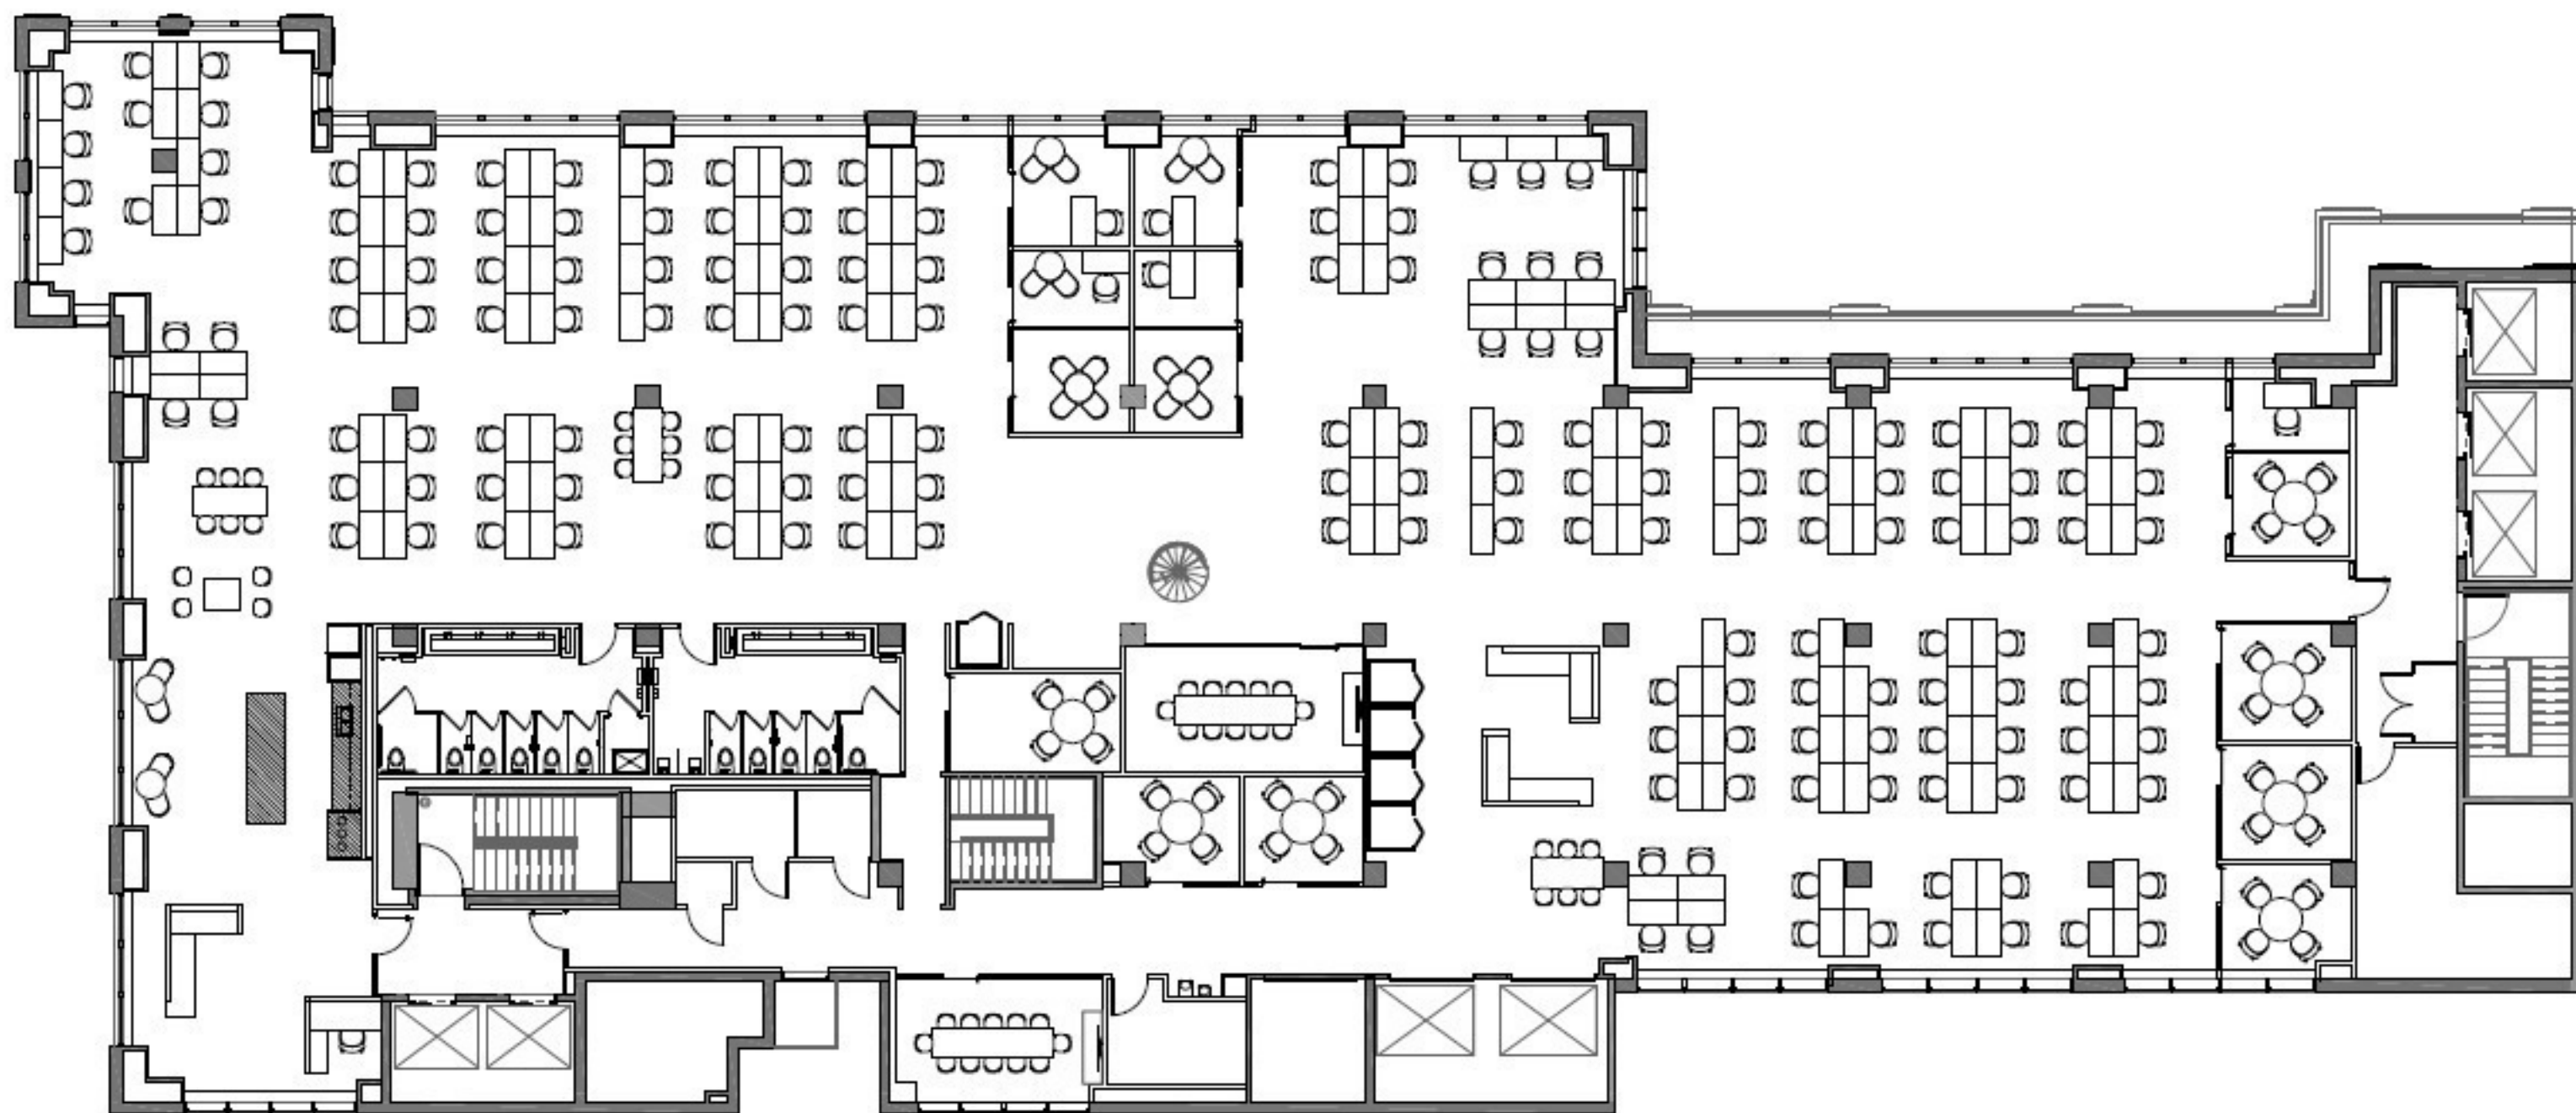

368 9TH AVENUE

17TH FLOOR AS BUILT PLAN