



SUITE 1411 - 2,025 RSF
(AS-BUILT PLAN)

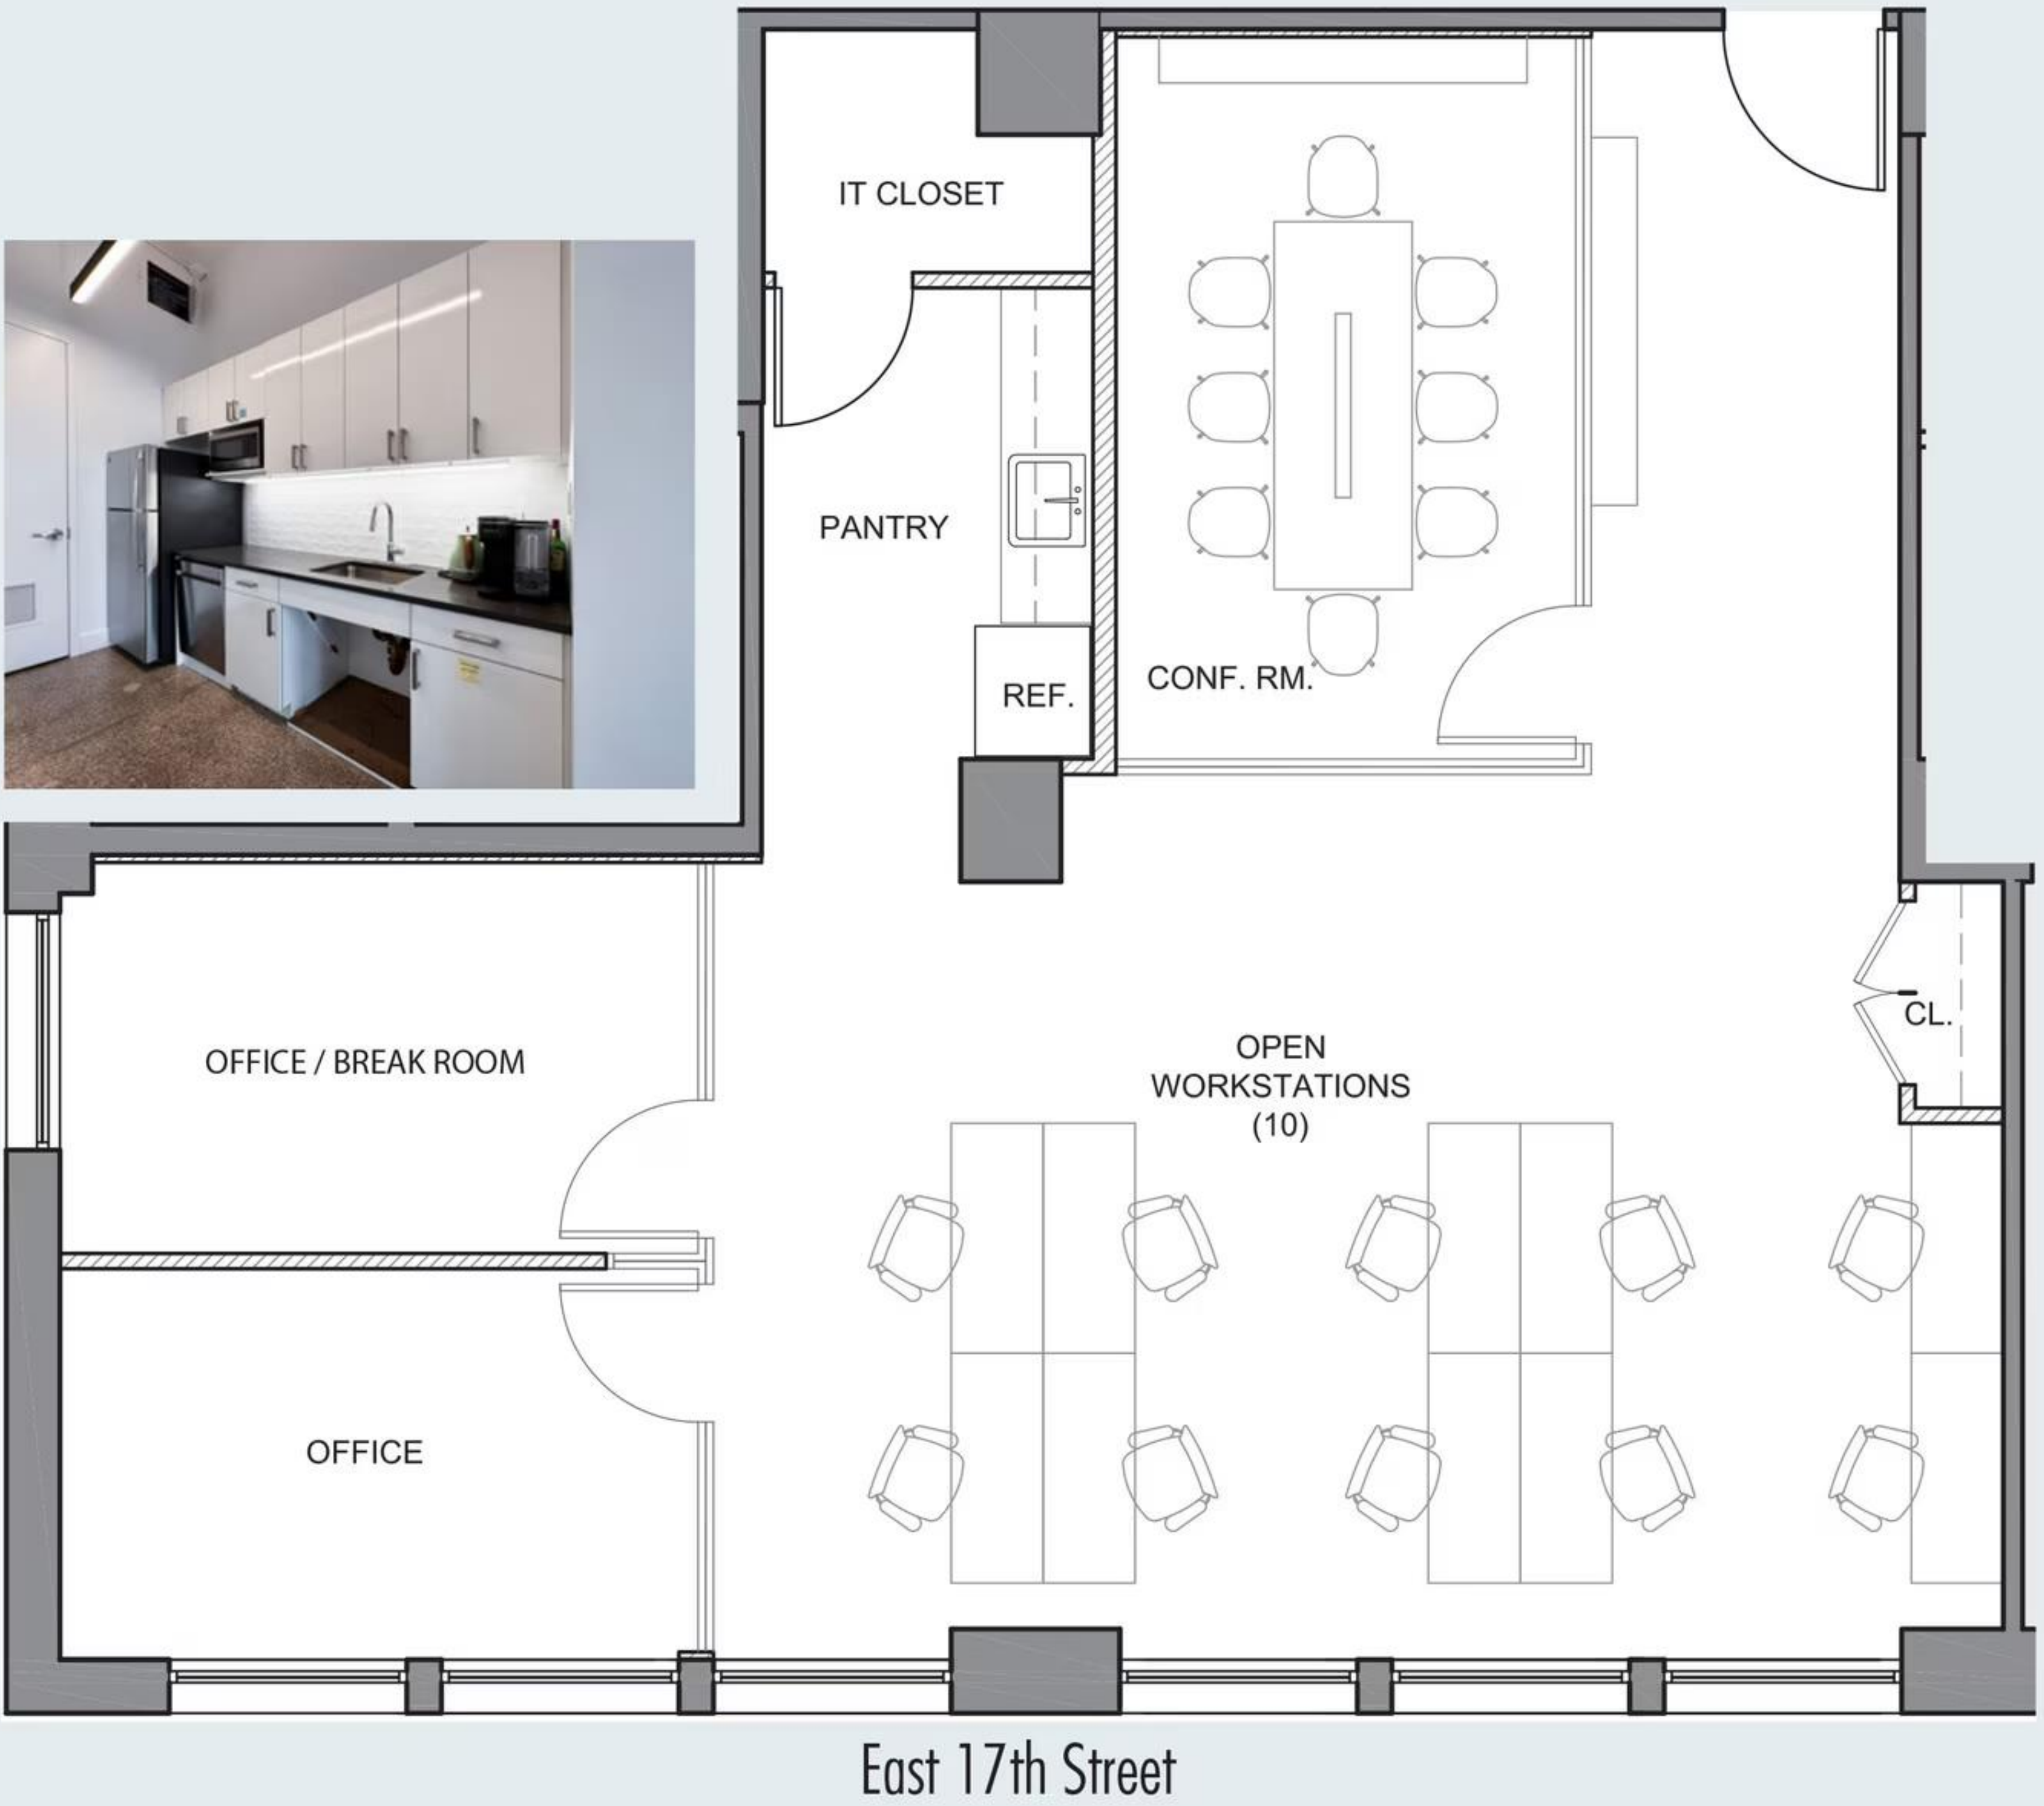

Office/Break Room

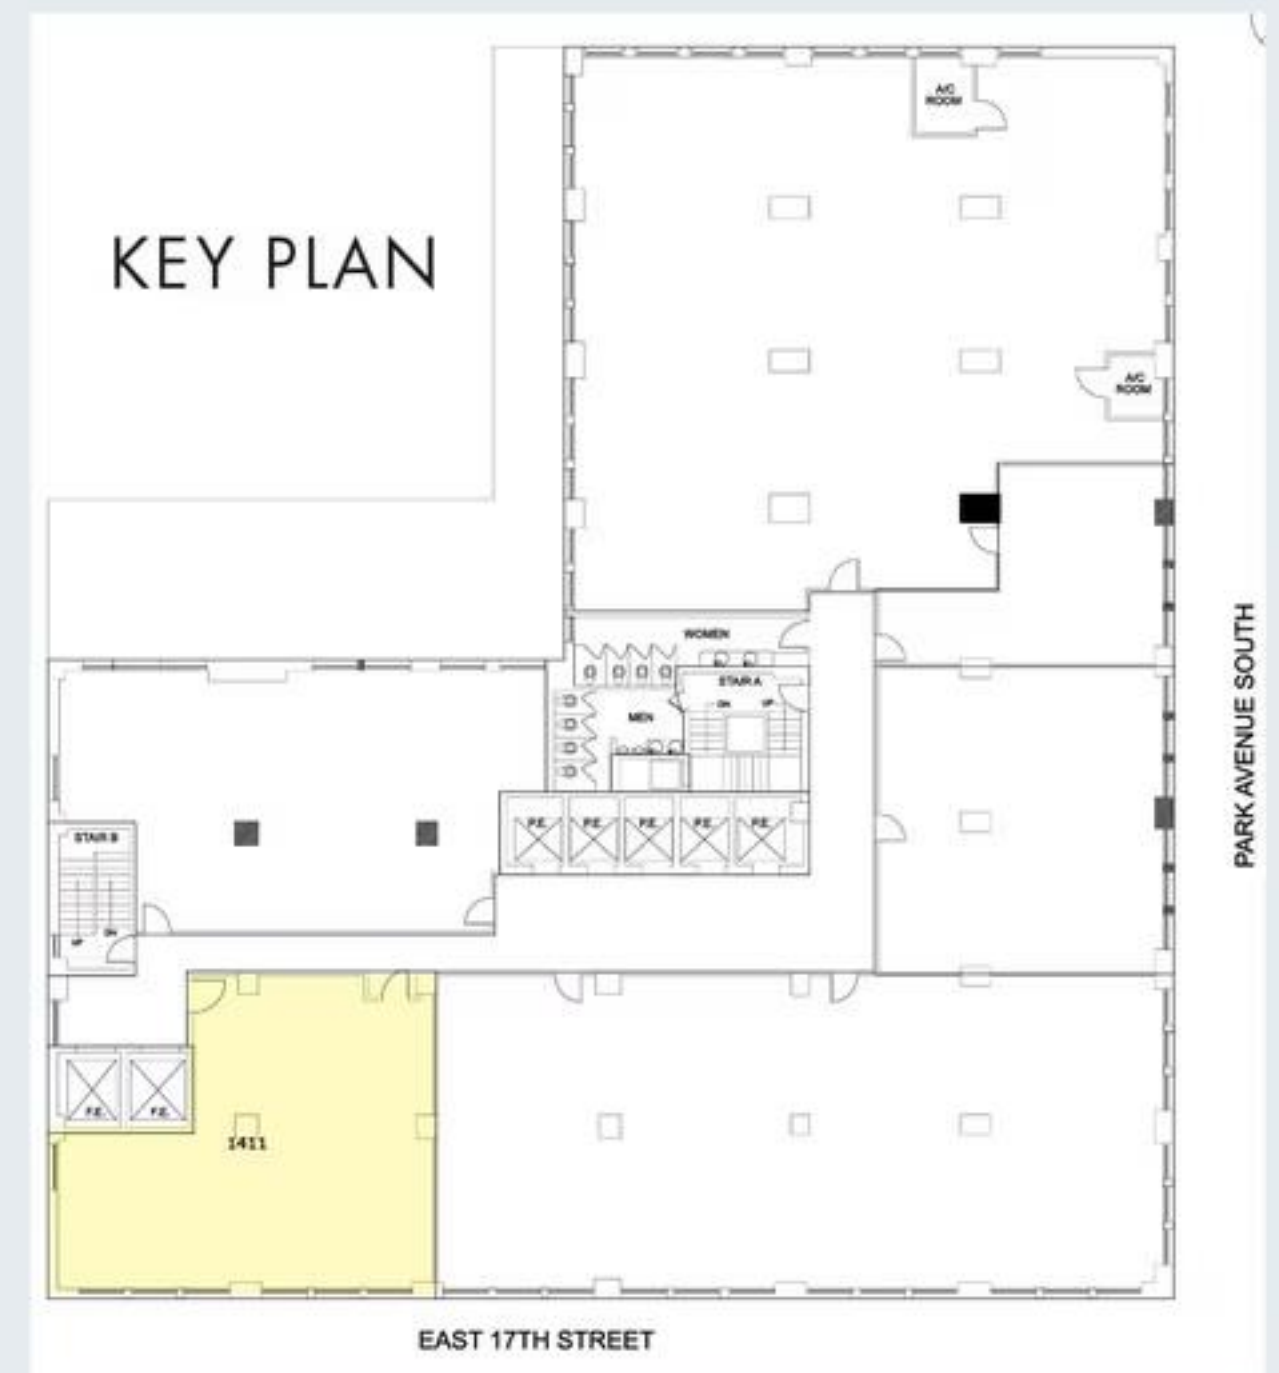

(Floor plan for descriptive purposes only; not to scale. Furniture shown for layout concept only.)