


SUITE 802 - 2,100 RSF
(AS-BUILT PLAN)

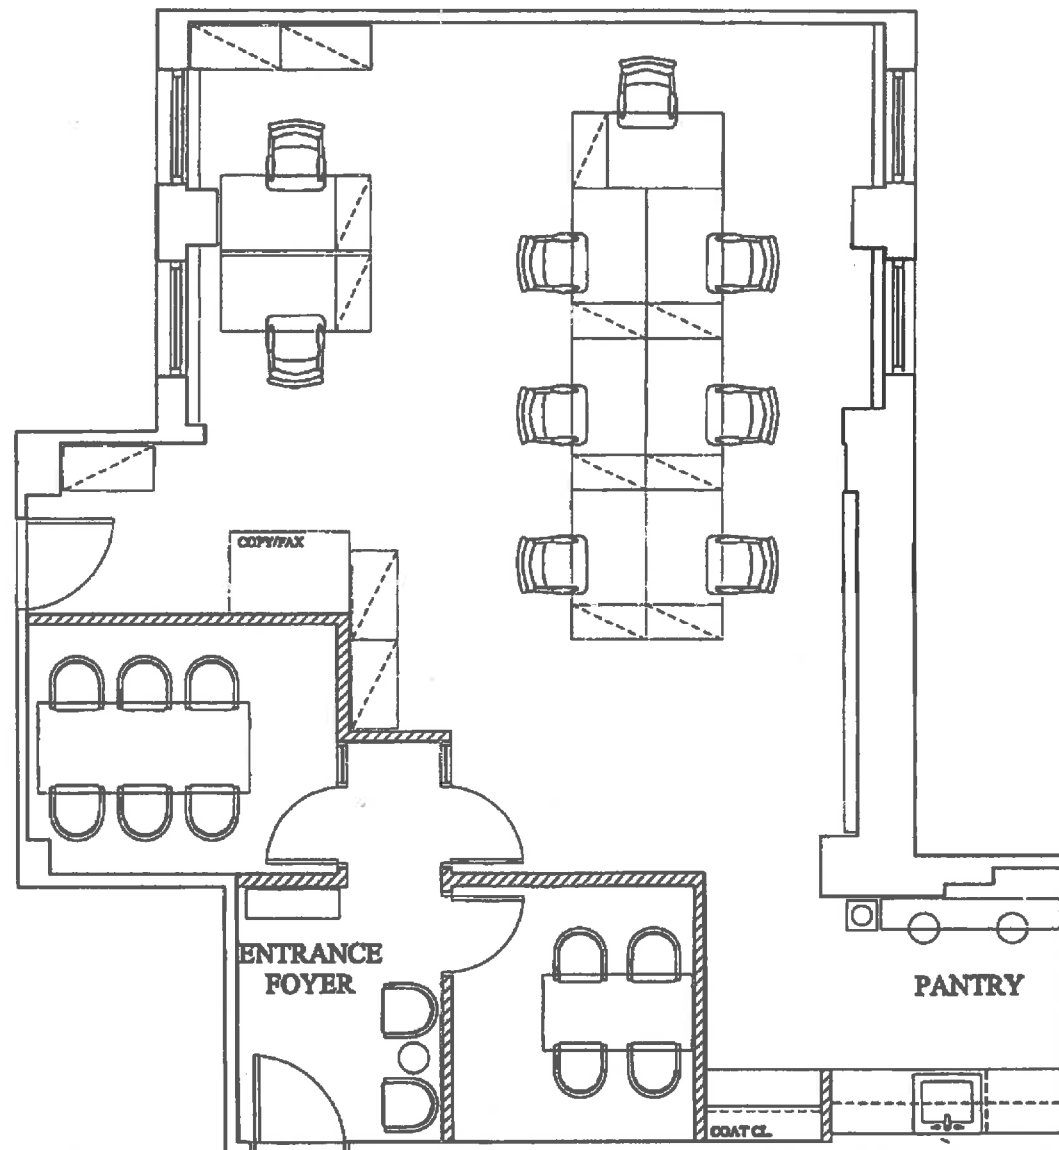

(Floor plan for descriptive purposes only; not to scale. Furniture shown for layout concept only)