



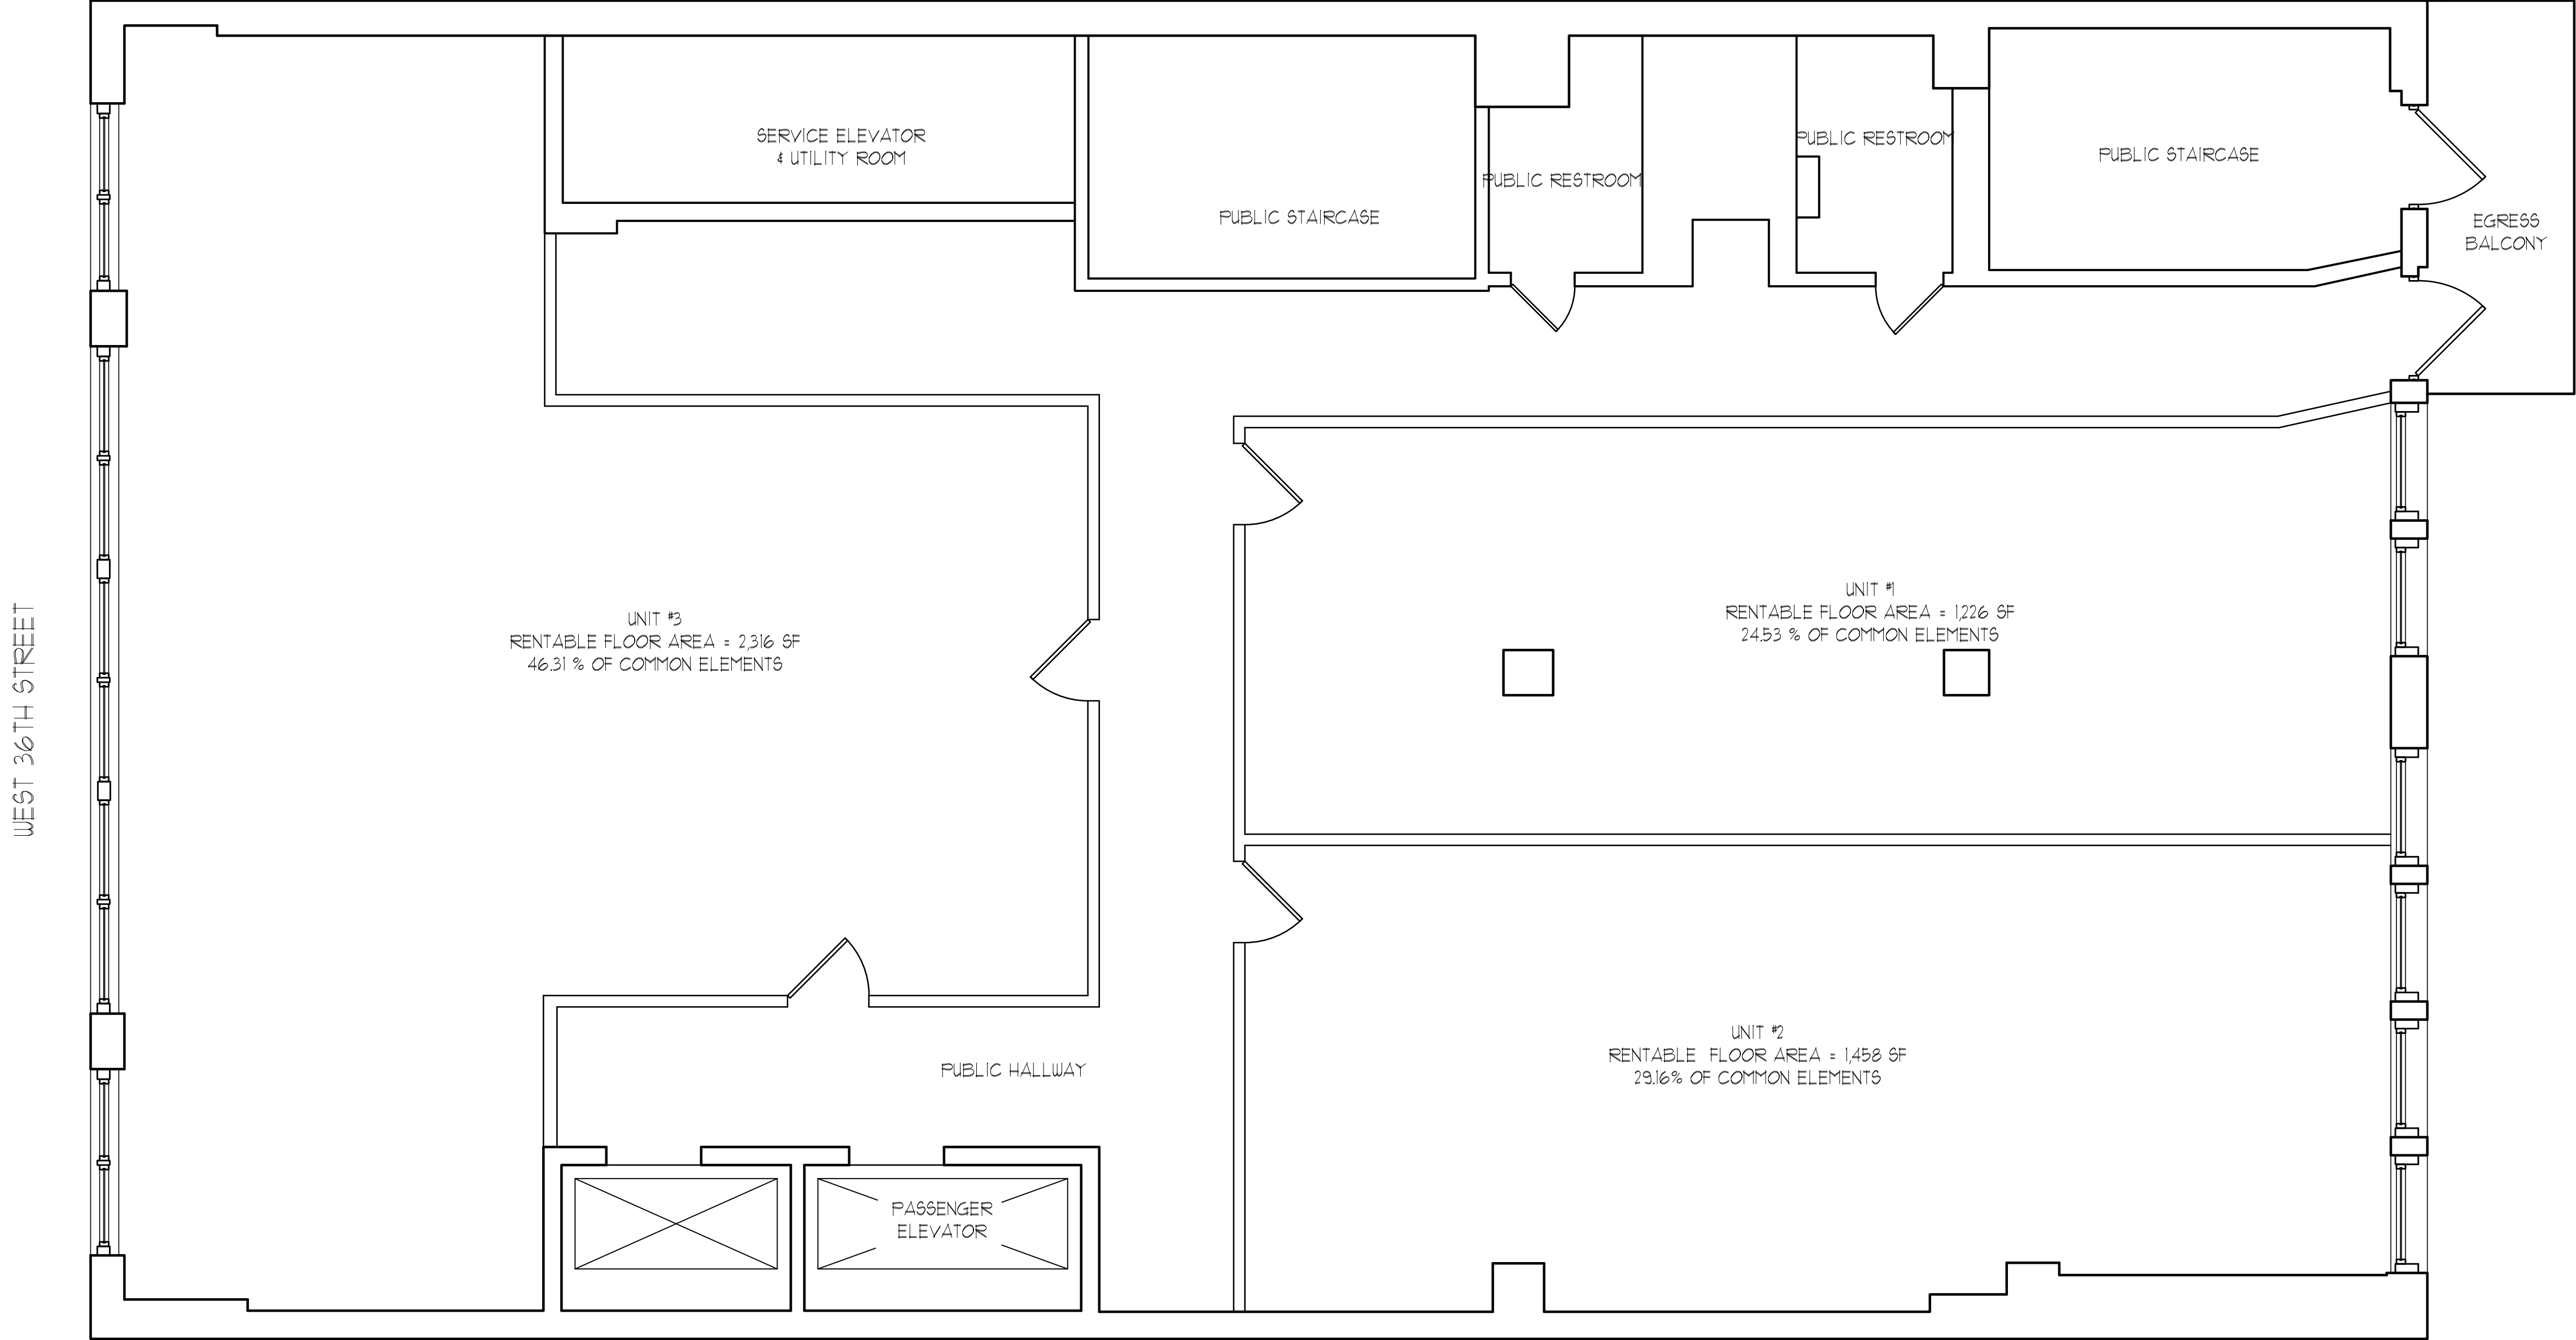

1 AS BUILT PLAN : 5TH FL  
SCALE: 1/4"=1'-0"

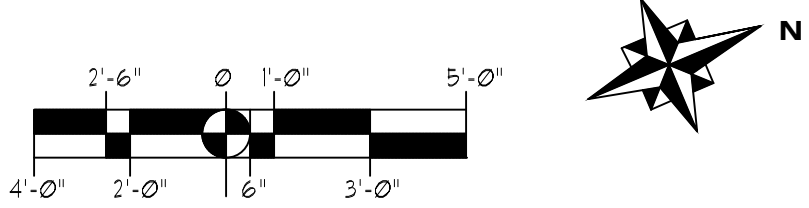

| NO. | REVISION | DATE |
|-----|----------|------|
|     |          |      |
|     |          |      |
The Contractor shall check and verify all dimensions on site and report any discrepancies in writing to Bchen Architect, before proceeding with work. All drawings are the property of Bchen Architect, and shall not be reproduced without the written consent of Bchen Architect. Drawings shall not be scaled for information. All Rights Reserved. This plan is approved only for work indicated on the application specification sheet; all other matters shown are not to be relied upon or to be considered as either being approved or in accordance with applicable codes.

PROJECT  
**AREA CALCULATION**  
**15 W 36TH STREET**  
**NEW YORK, NY**

**AS BUILT**  
**5TH FLOOR**

|                  |                     |
|------------------|---------------------|
| SEAL & SIGNATURE | DATE: 12-28-2024    |
|                  | SCALE: AS NOTED     |
|                  | PRO. No.: 24-AR-018 |
|                  | DRAWING BY: BC      |
|                  | CHECKED BY: BC      |
| DWG No.:         |                     |
| 5 TH FL          |                     |
| DWG PAGE: 1 OF 1 |                     |