## TOWER56

@ PARK AVENUE


## Partial 4th Floor

As-Built Plan

2,496 RSF

## Highlights

- Currently built, move-in ready
- · Landlord can modify
- Recent building renovation featuring a new lobby and multi-level amenity center
- 3 Private Offices
- 4 Open Areas
- 1 Conference Room
- 1 Pantry
- I.T.

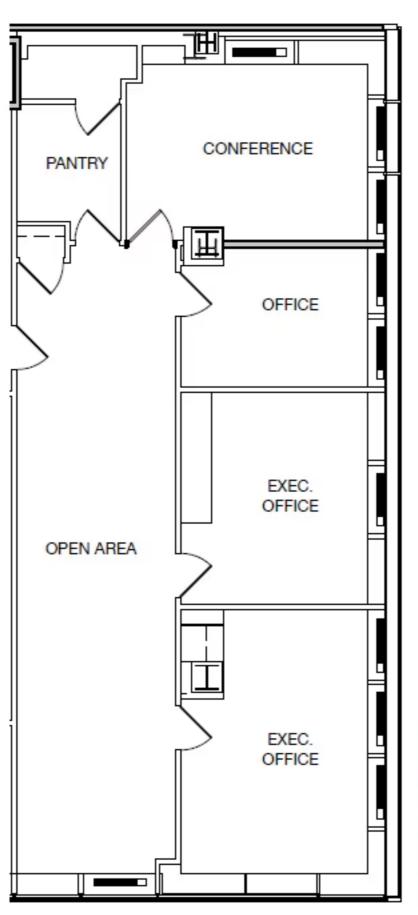

EAST 56TH STREET





