


Floor 50

Densified As-Built Plan

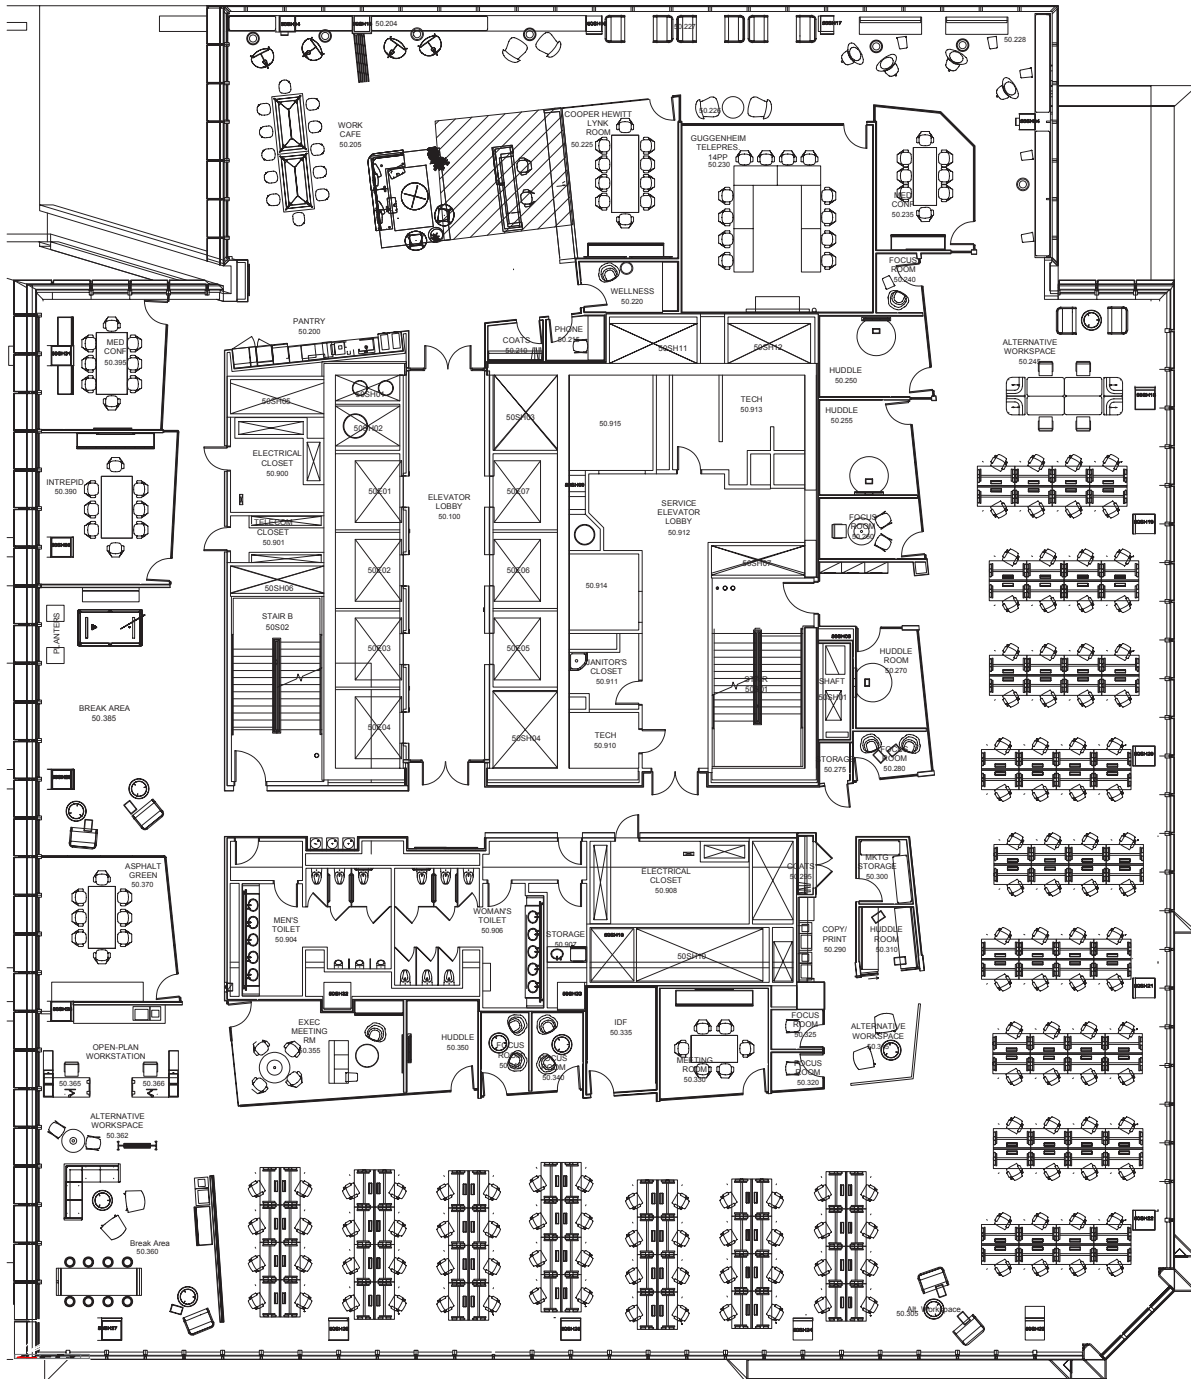

KEY

130 Bench Stations	5 Small Meeting Rooms	2 Pantries
2 Large Conference Rooms	6 Collaborative Workspaces	1 Wellness Room
1 Executive Conference Room	8 Focus / Phone Rooms	1 Copy & Print
5 Medium Conference Rooms	1 Kitchen / Café	