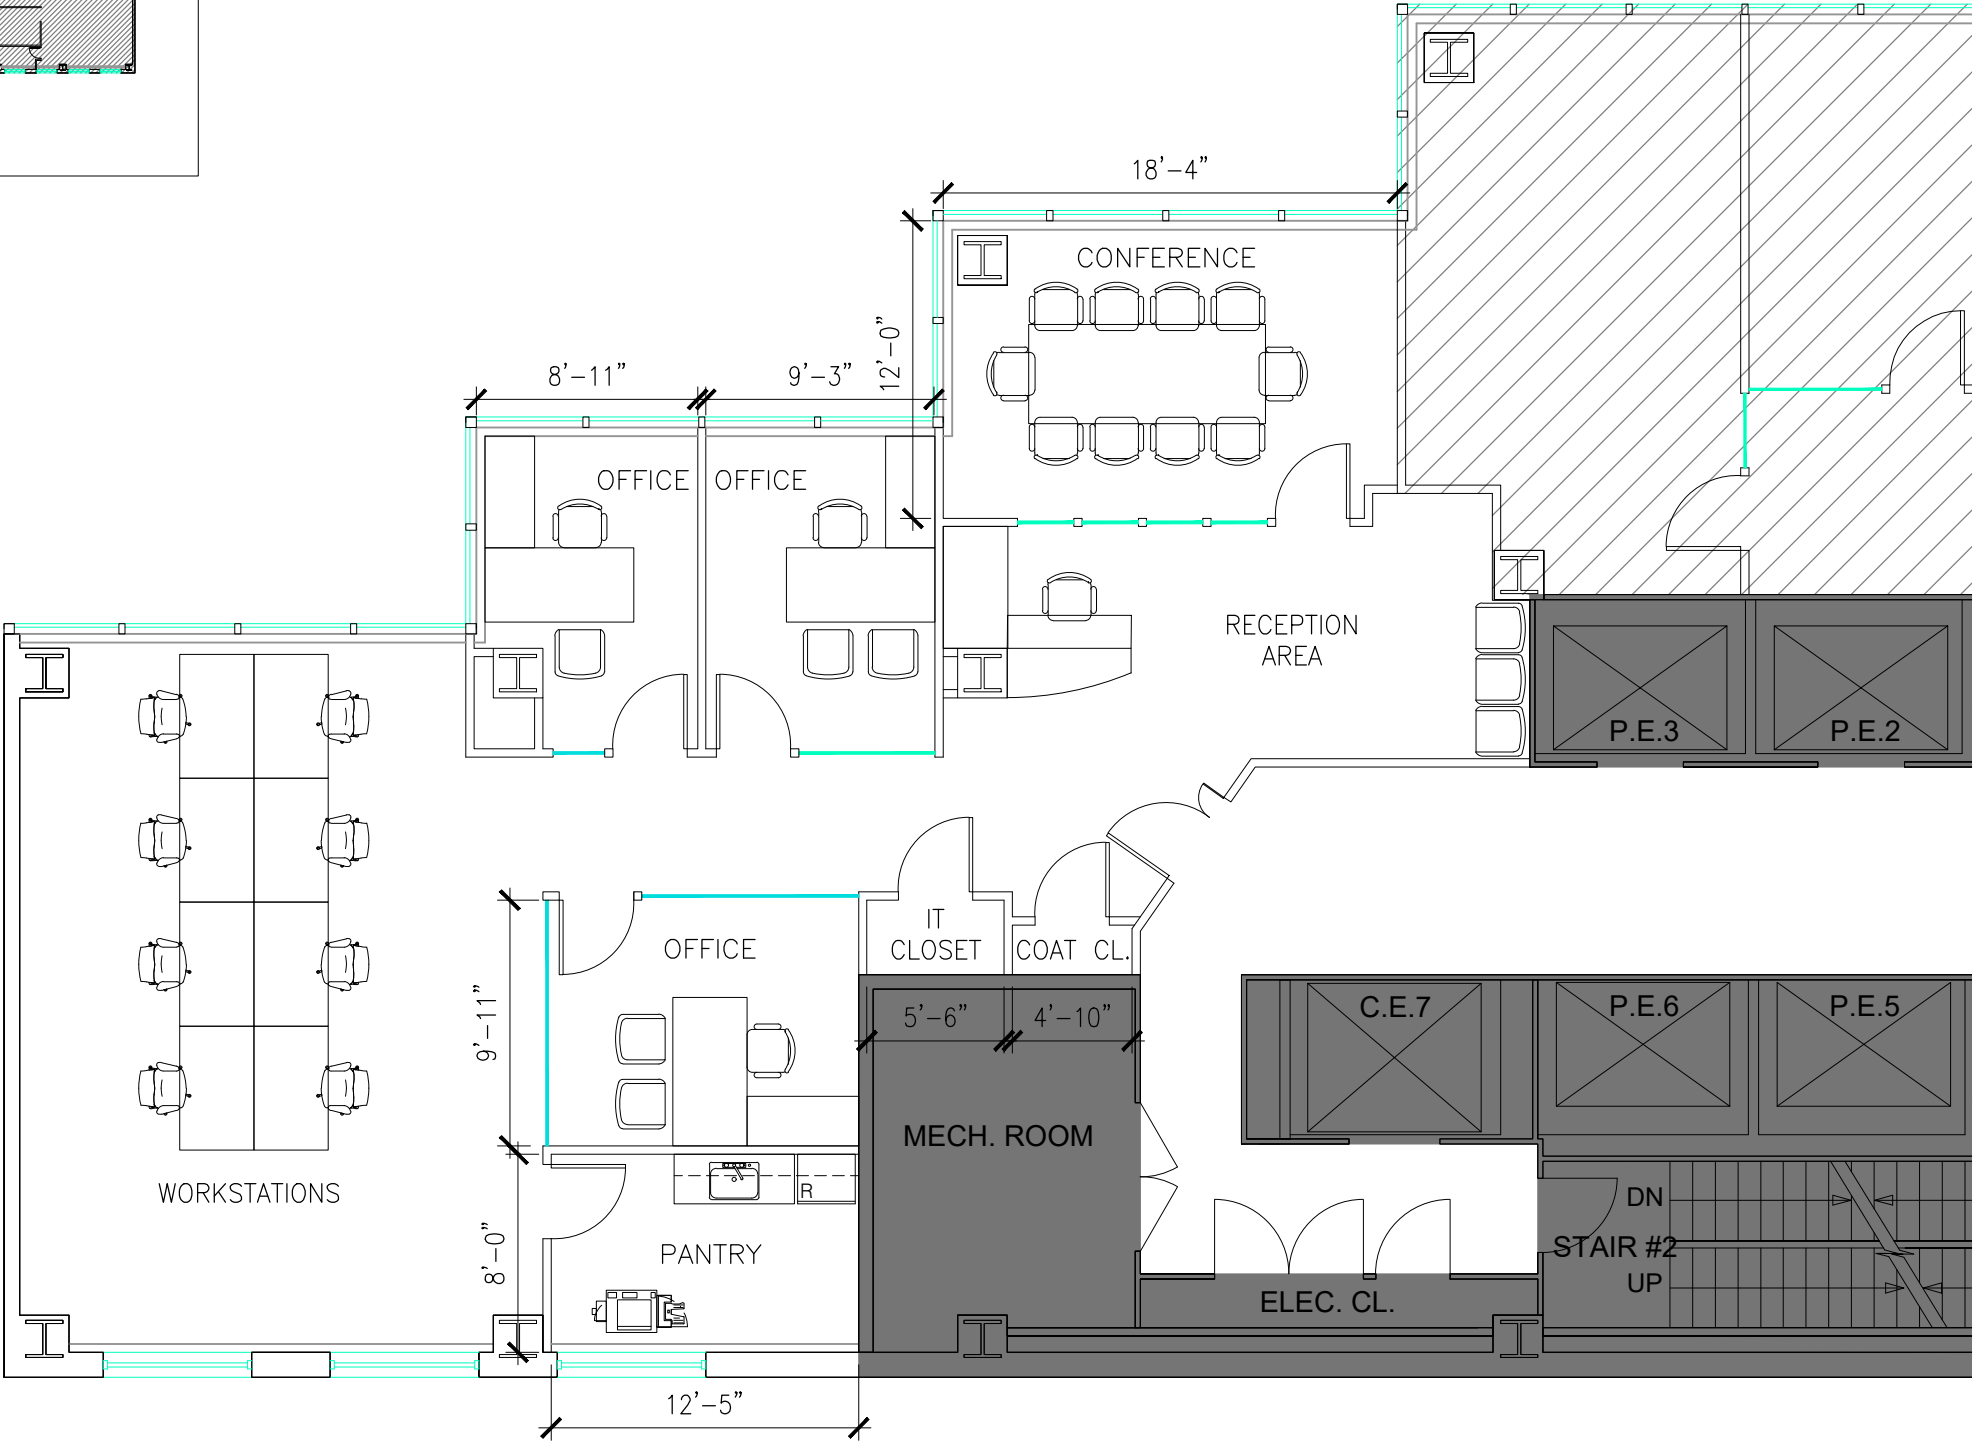
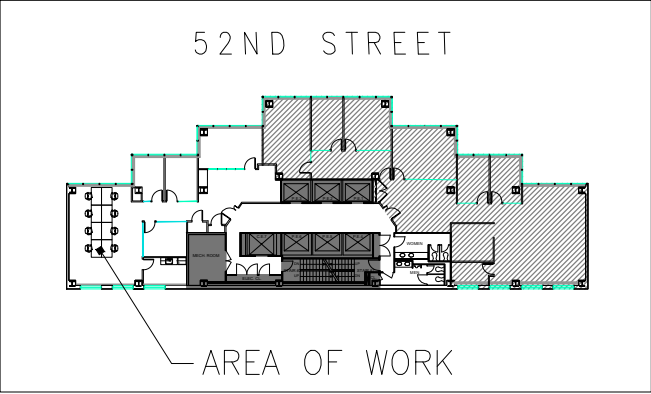


SUITE SUMMARY:

1	10-PERSON CONFERENCE
3	OFFICES
8	BENCHING WORKSTATIONS
	RECEPTION WITH WAITING
	PANTRY
	IT ROOM
	COAT CLOSET

AS-BUILT PLAN
150 EAST 52ND STREET
NEW YORK, NY
10TH FLOOR - WEST
3,004 RSF