


SUITE 1104 - 3,226 RSF  
(AS-BUILT PLAN)

WEST 21ST STREET

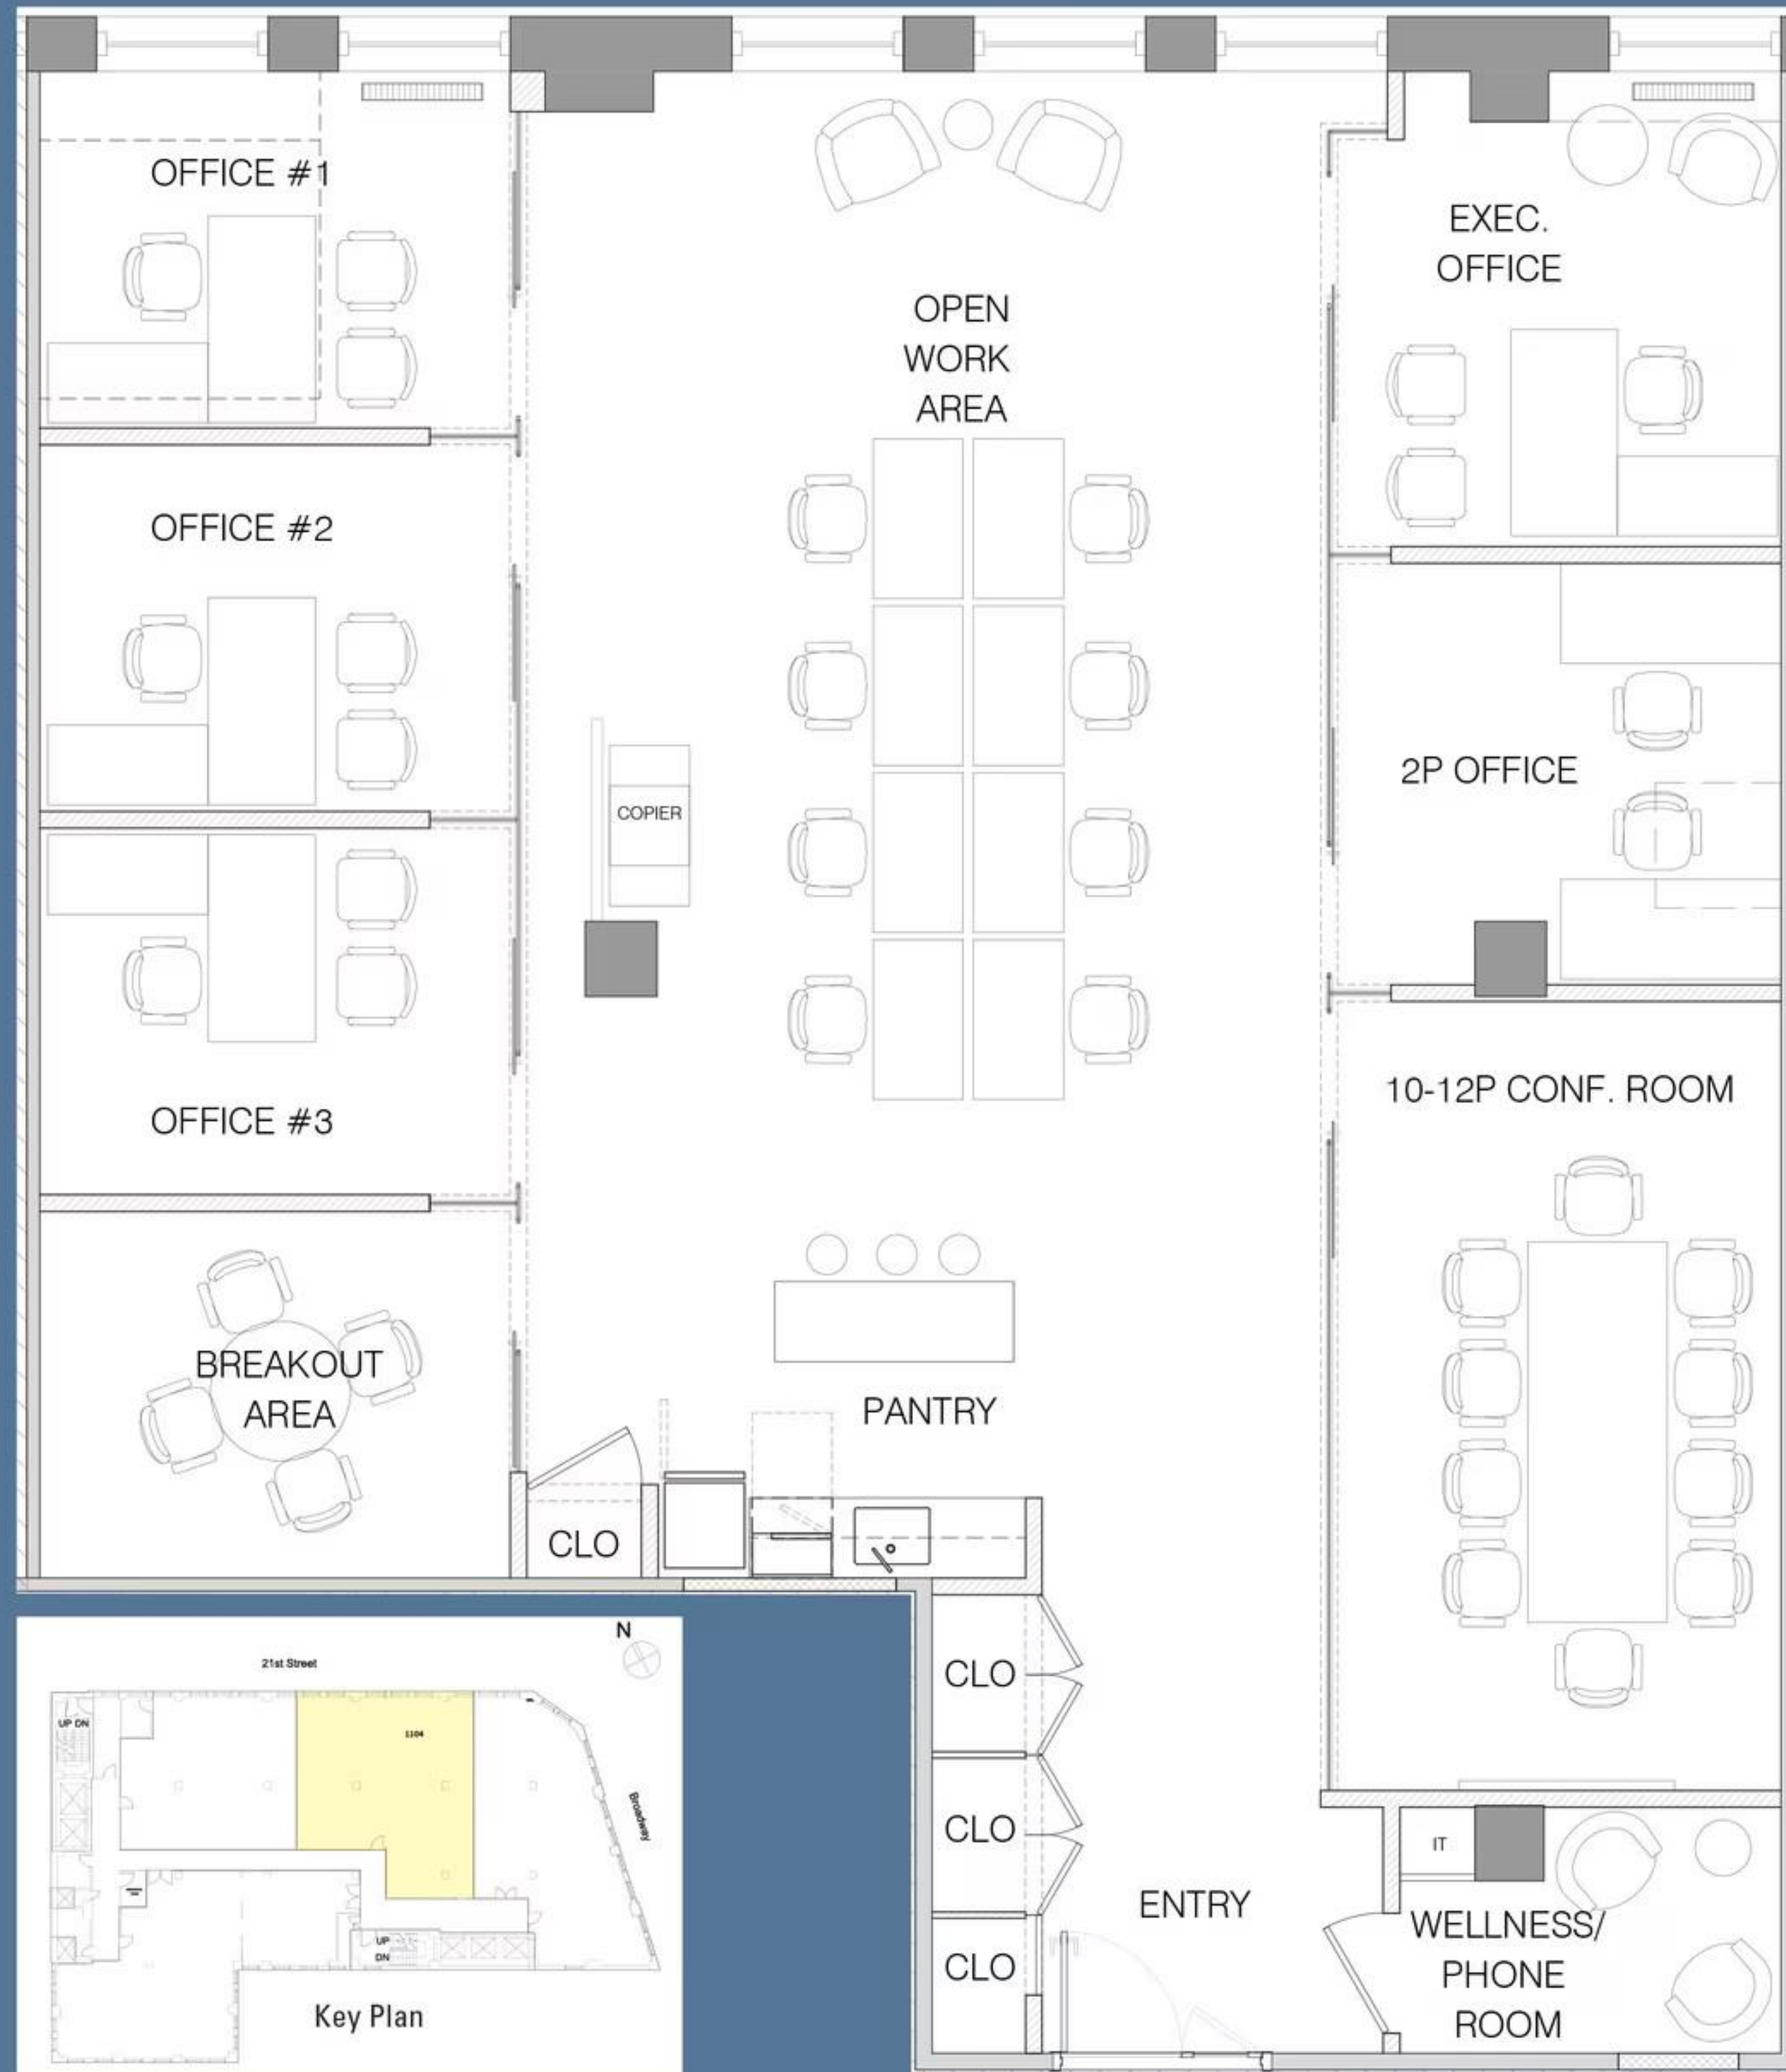

*(Floor plan for descriptive purposes only; not to scale. Furniture shown for layout concept only)*