
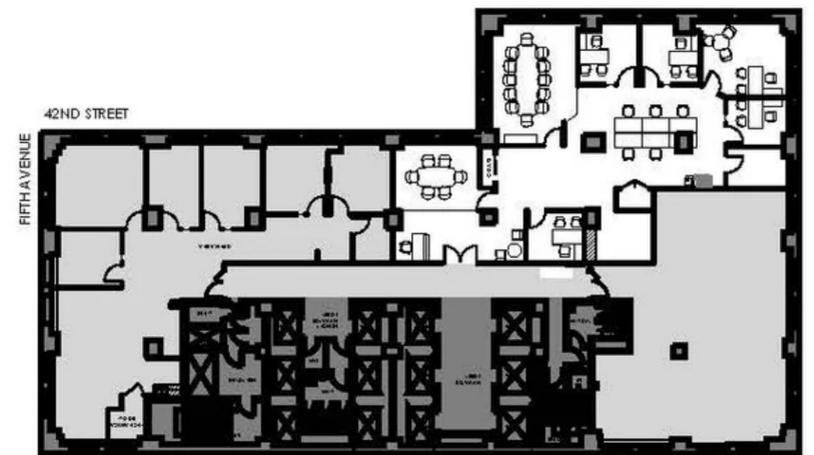


SPACE	QUANTITY
RECEPTION	1
OFFICE	5
WORKSTATIONS (5' LONG)	5
12P CONFERENCE	1
6P CONFERENCE	2
PANTRY	1
COATS	1
IT CLOSET	1

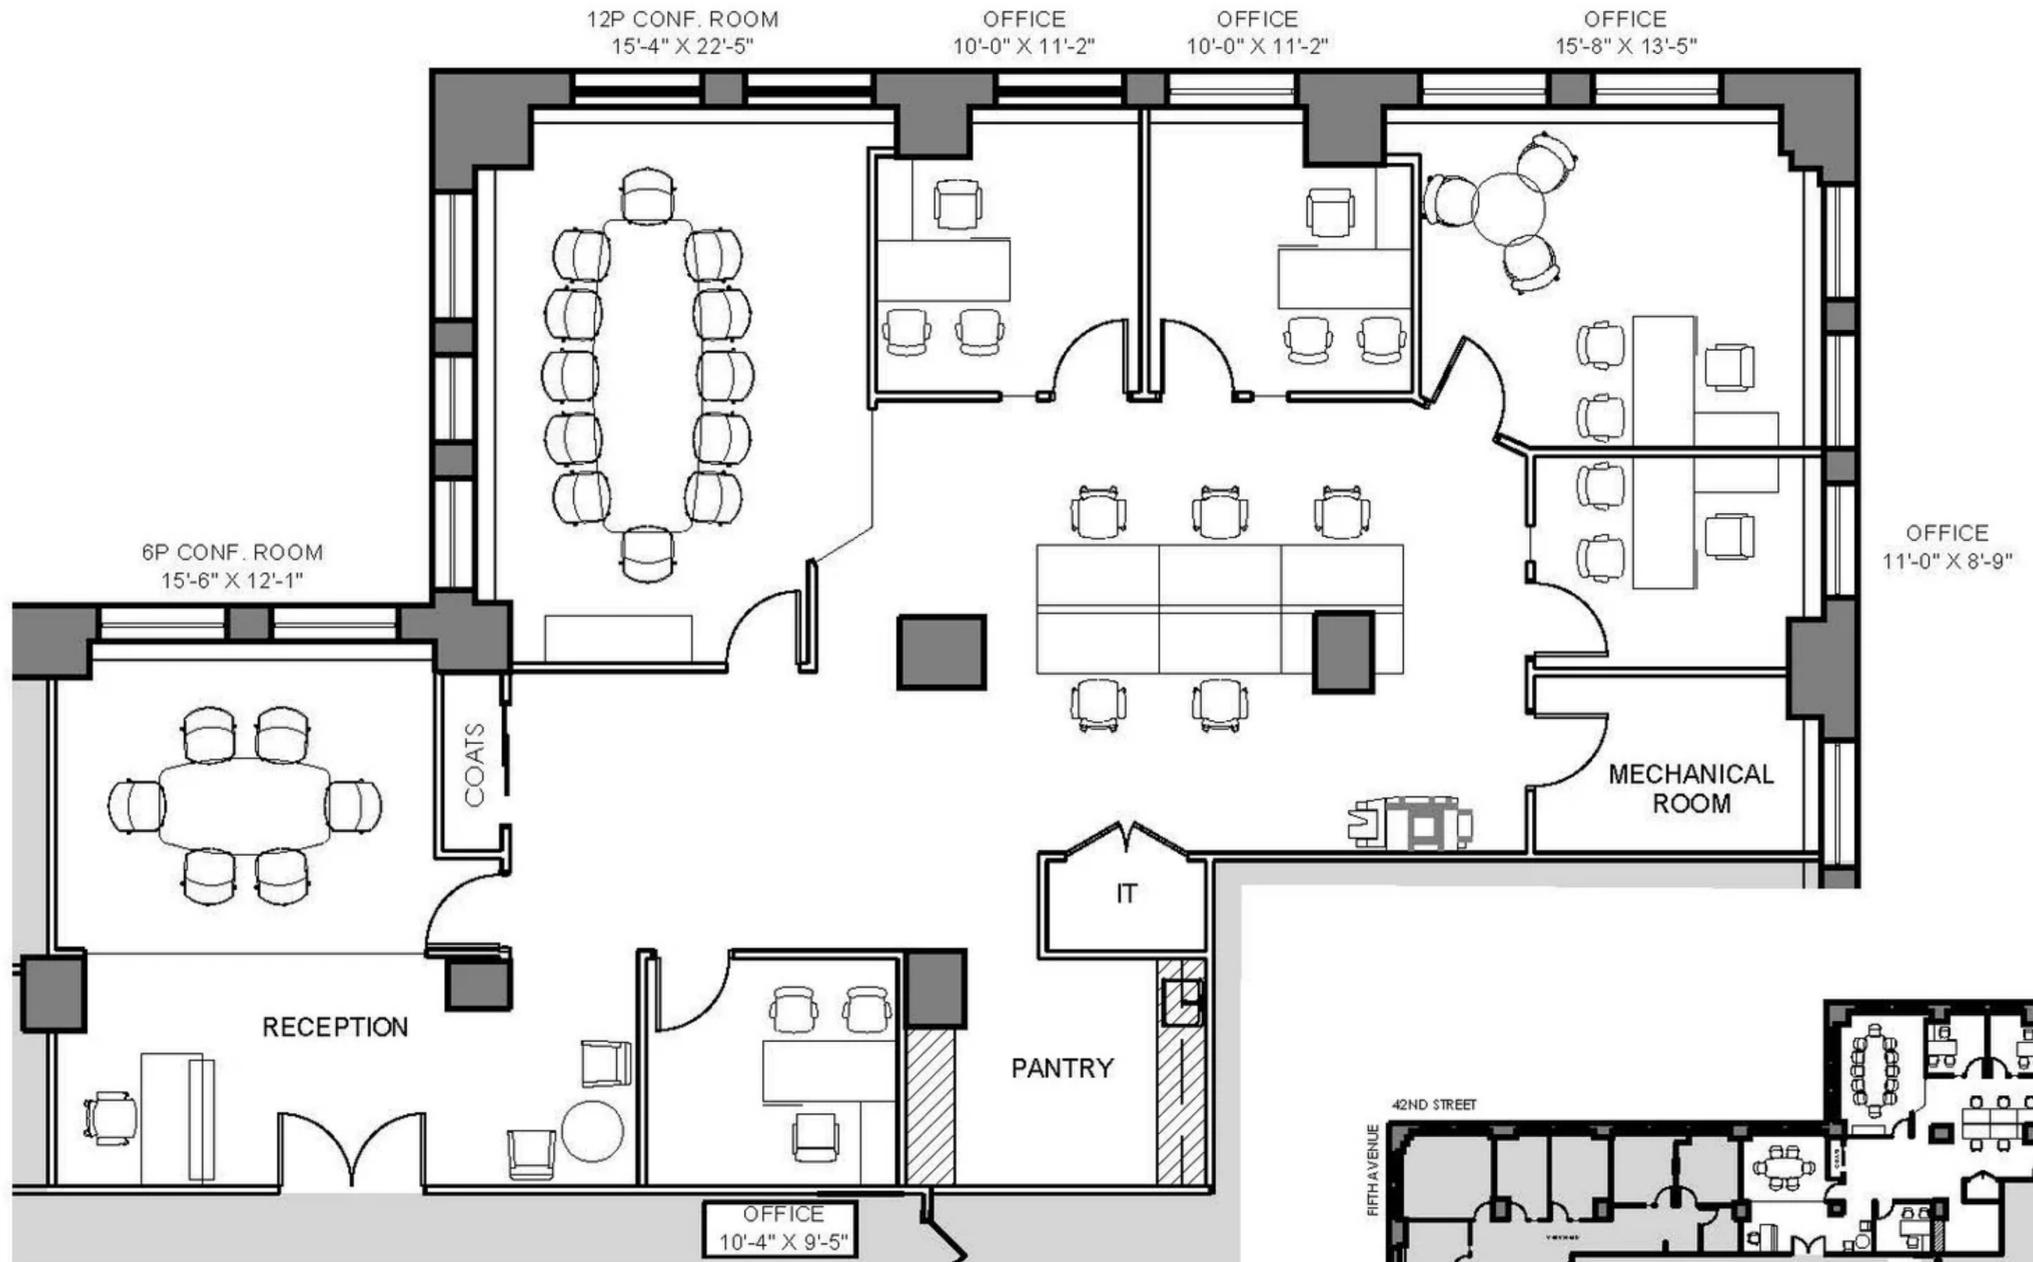

KEY PLAN

500 5TH AVENUE
SUITE 3020

AS-BUILT PLAN

DWG: SSK-500-47