


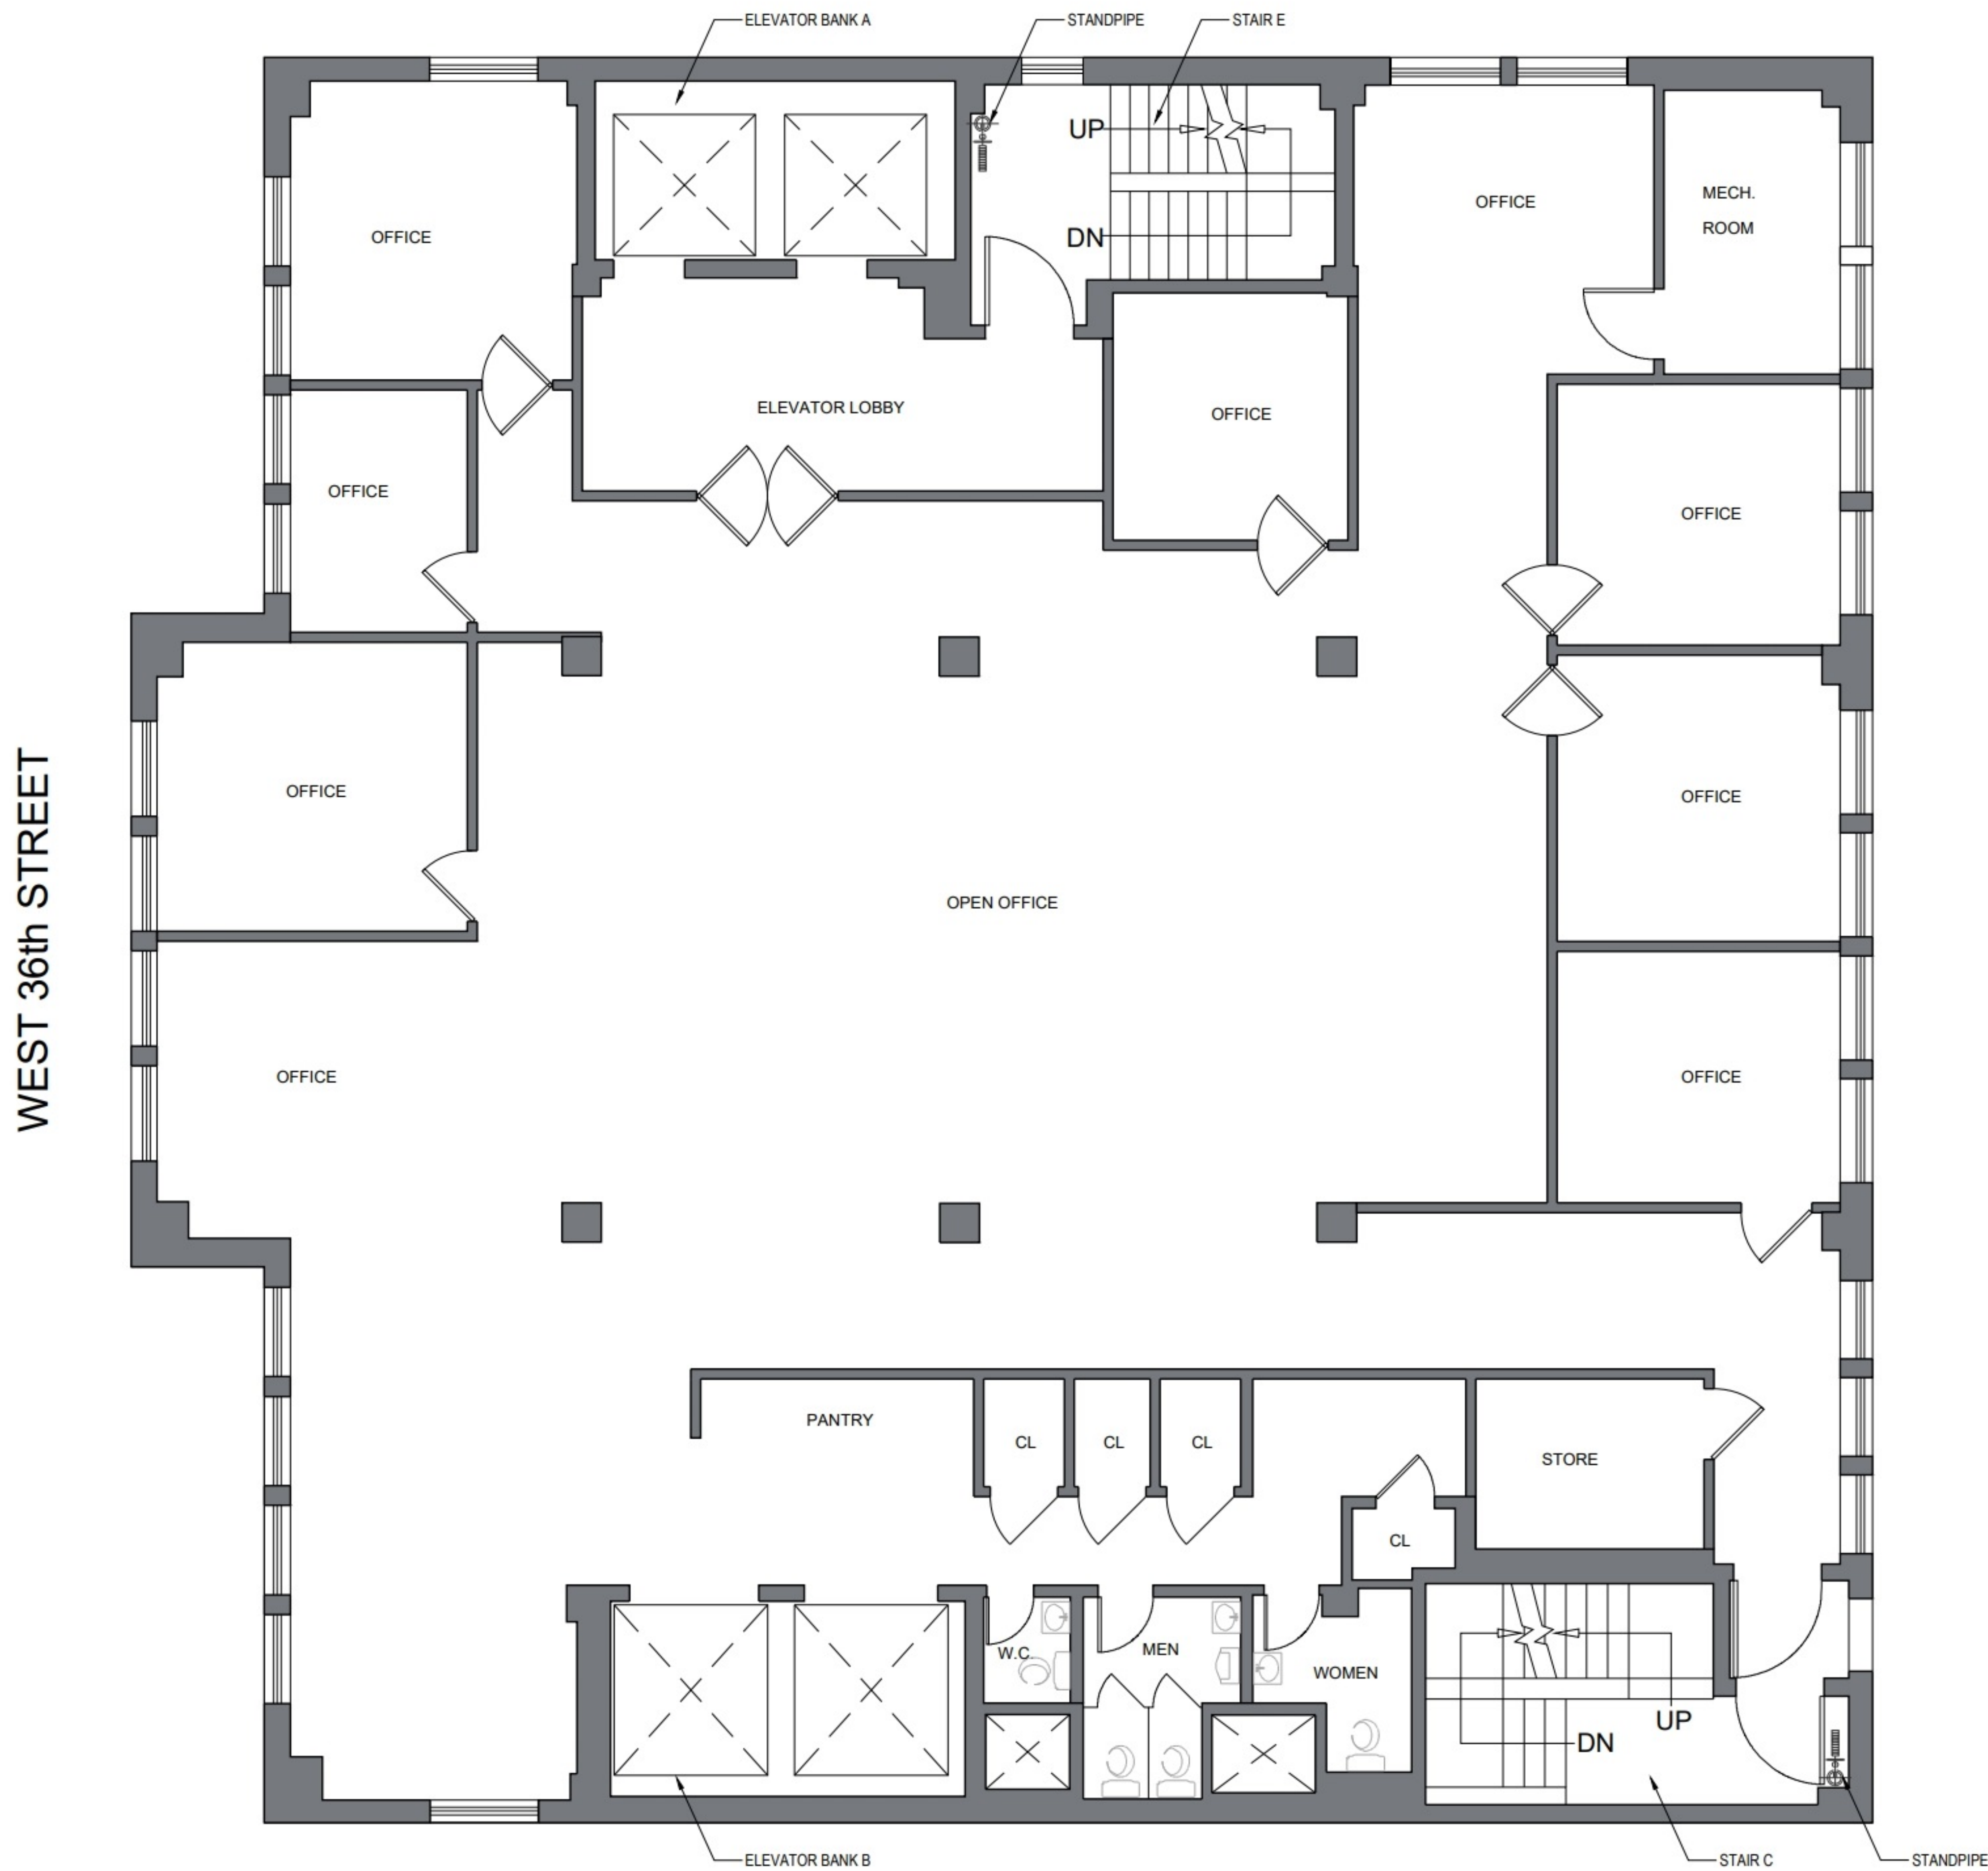


1 | 15th FLOOR EXISTING PLAN
SCALE: 3/16" = 1'-0"

01	07.07.2023	ISSUE TO CLIENT
REV.	DATE	ISSUE
PROJECT TITLE:		

**142 WEST 36th STREET
AS-BUILT PLAN**

142 W 36 ST
NEW YORK, NY 10018

KEY PLAN:

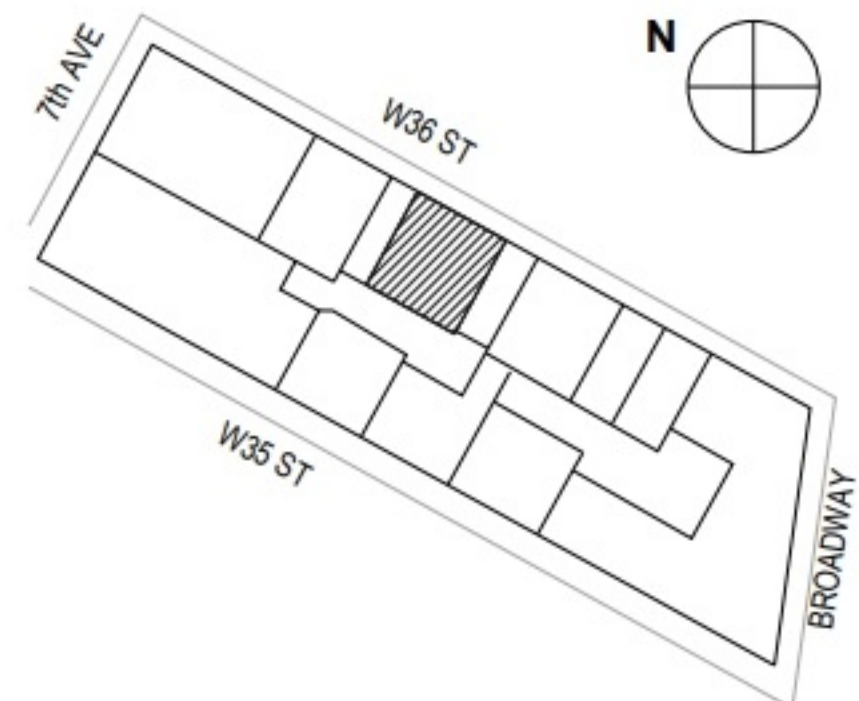


DRAWING TITLE:

15th FLOOR - AS BUILT PLAN

PROJECT #: 2306107

SEAL & SIGNATURE:	DATE:	07/07/2023
	SCALE:	AS SHOWN
	DRAWN BY:	LD
	CHECKED BY:	FG
	DESIGN BY:	THREESTUDIO
	SHEET NO.	

A-115.00

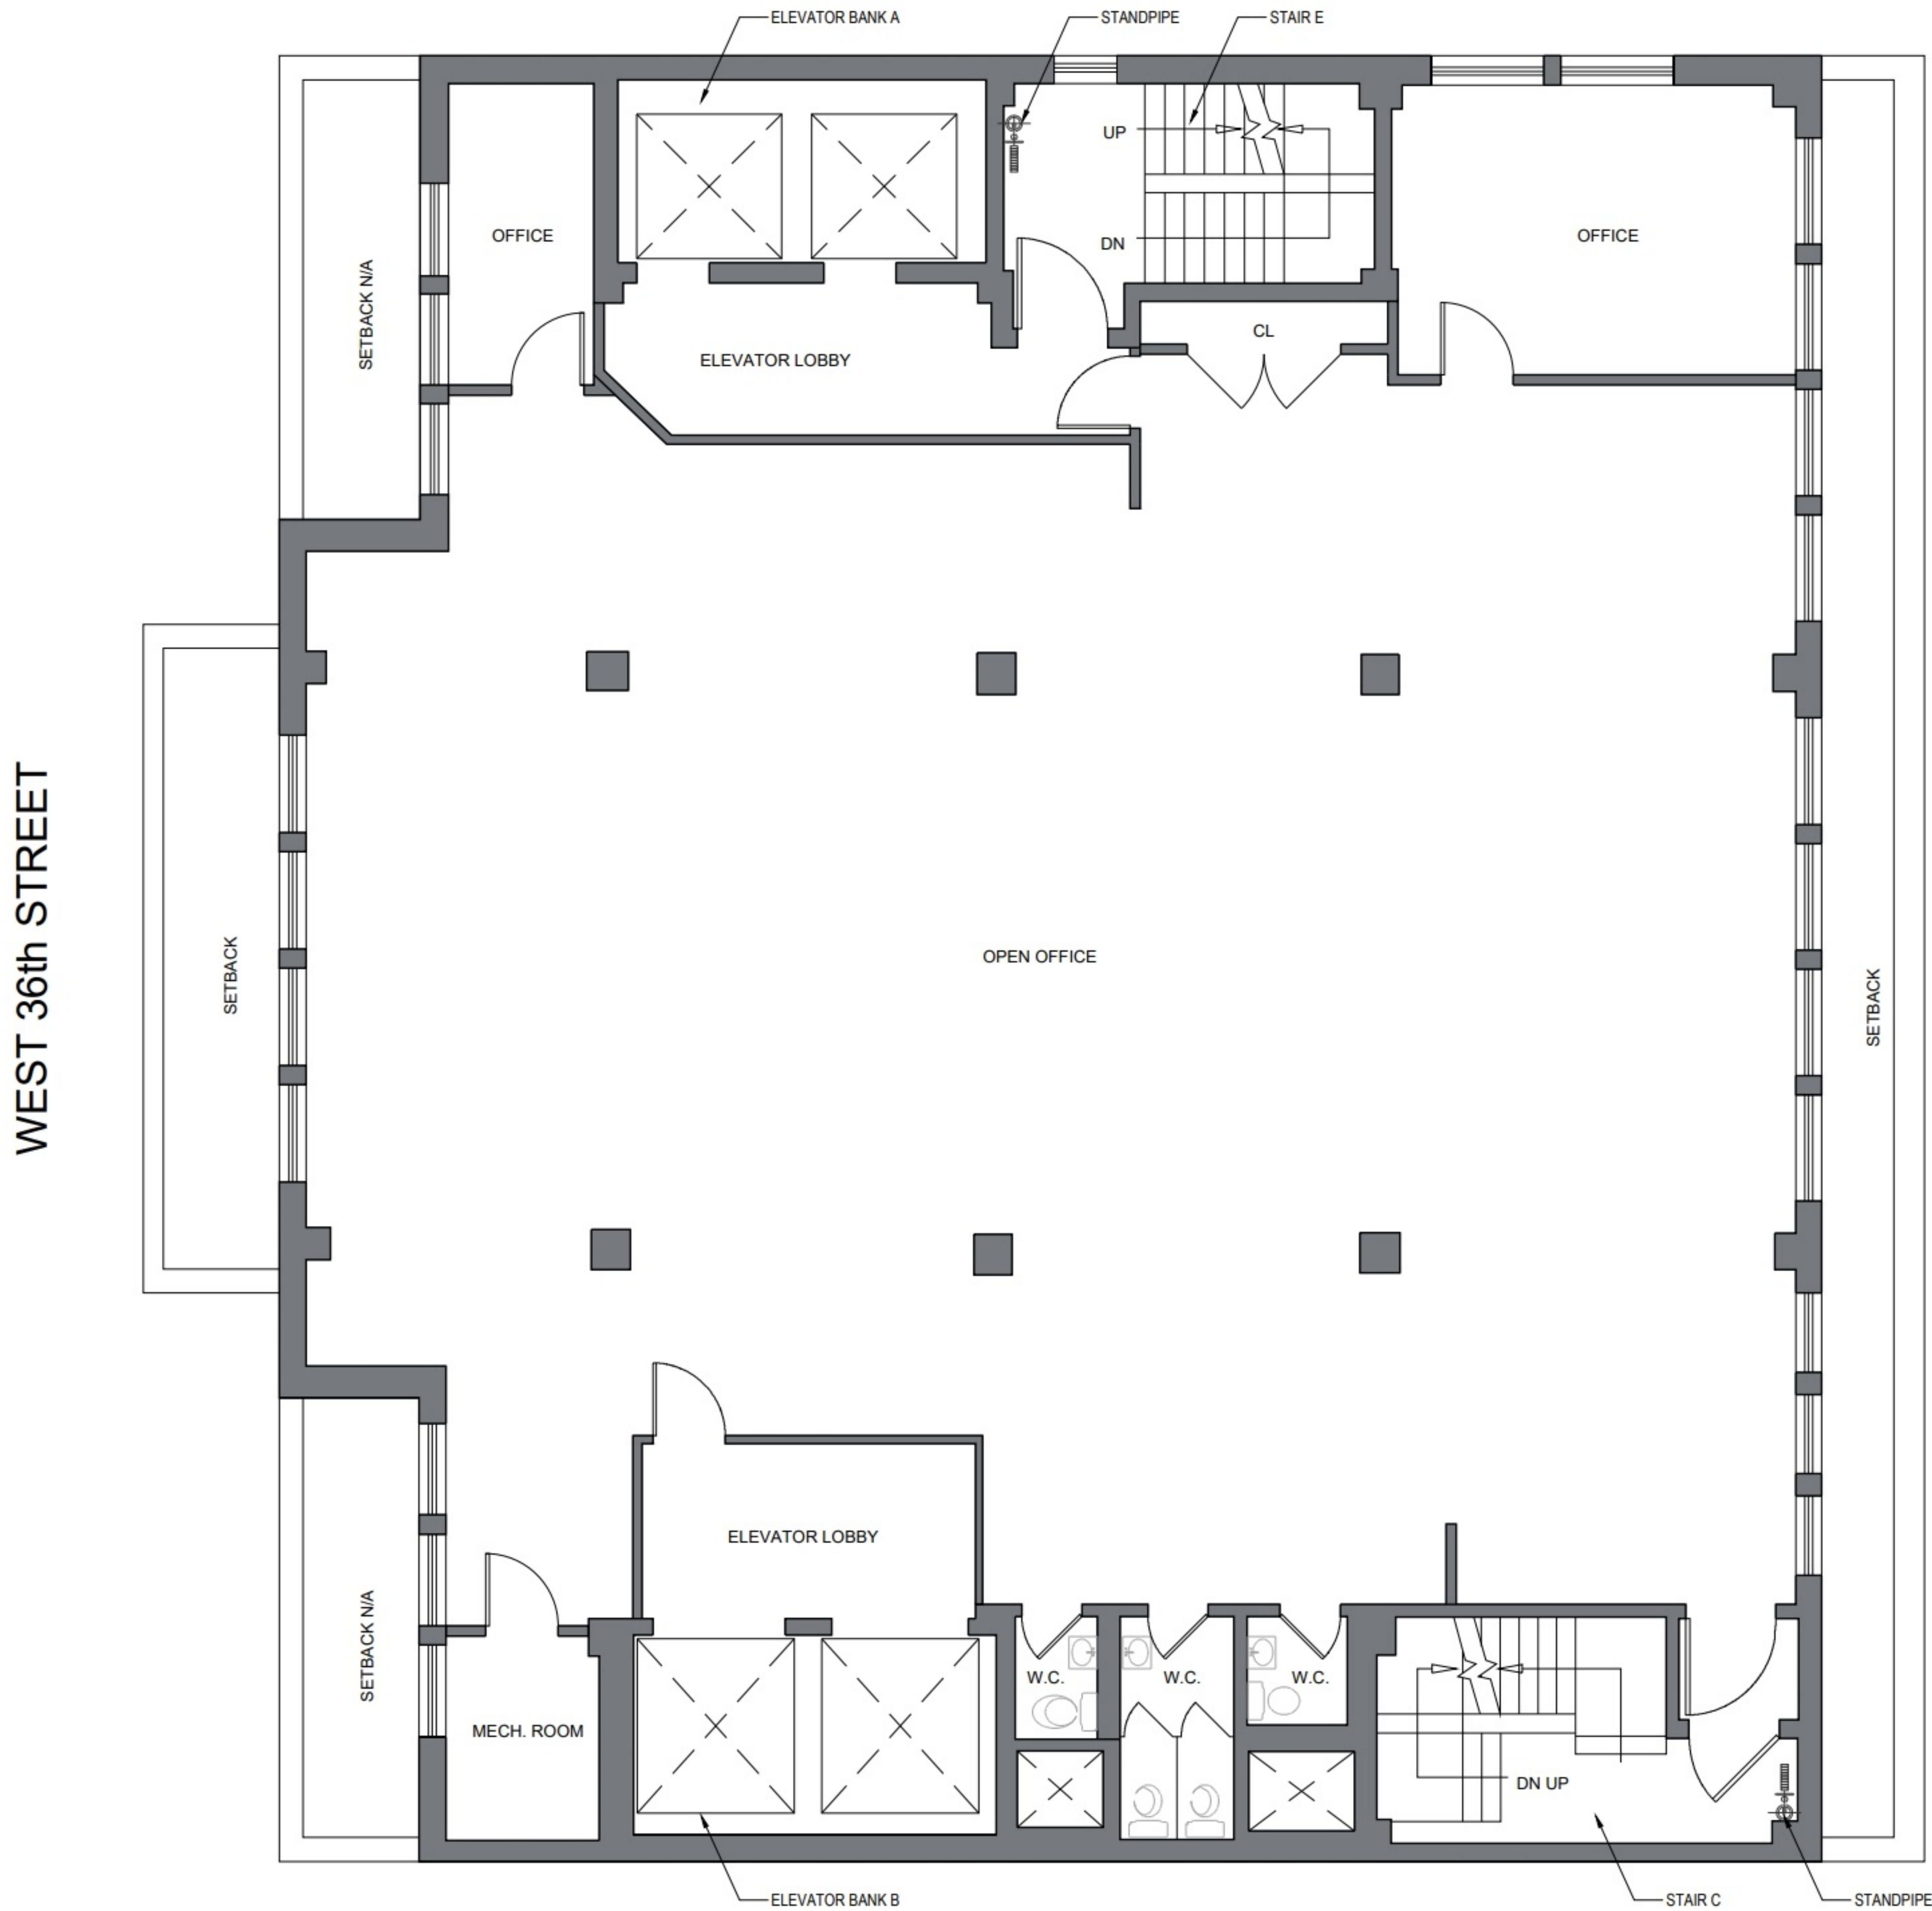

1 | 16th FLOOR EXISTING PLAN
SCALE: 3/16" = 1'-0"


01	07.07.2023	ISSUE TO CLIENT
REV.	DATE	ISSUE

PROJECT TITLE:

142 WEST 36th STREET
AS-BUILT PLAN

142 W 36 ST
NEW YORK, NY 10018

KEY PLAN:

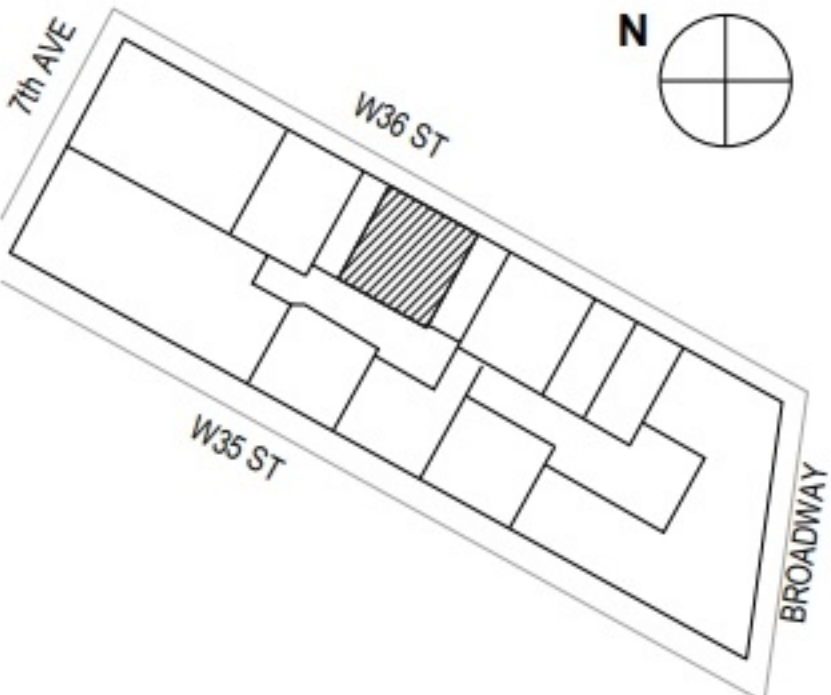

DRAWING TITLE:

16th FLOOR - AS BUILT PLAN

PROJECT #: 2306107

SEAL & SIGNATURE:

DATE:	07/07/2023
SCALE:	AS SHOWN
DRAWN BY:	LD
CHECKED BY:	FG
DESIGN BY:	THREESTUDIO
SHEET NO.	

A-116.00




1 14th FLOOR EXISTING PLAN
SCALE: 3/16" = 1'-0"

01	07.07.2023	ISSUE TO CLIENT
REV.	DATE	ISSUE
PROJECT TITLE:		

**142 WEST 36th STREET
AS-BUILT PLAN**

142 W 36 ST
NEW YORK, NY 10018

KEY PLAN:

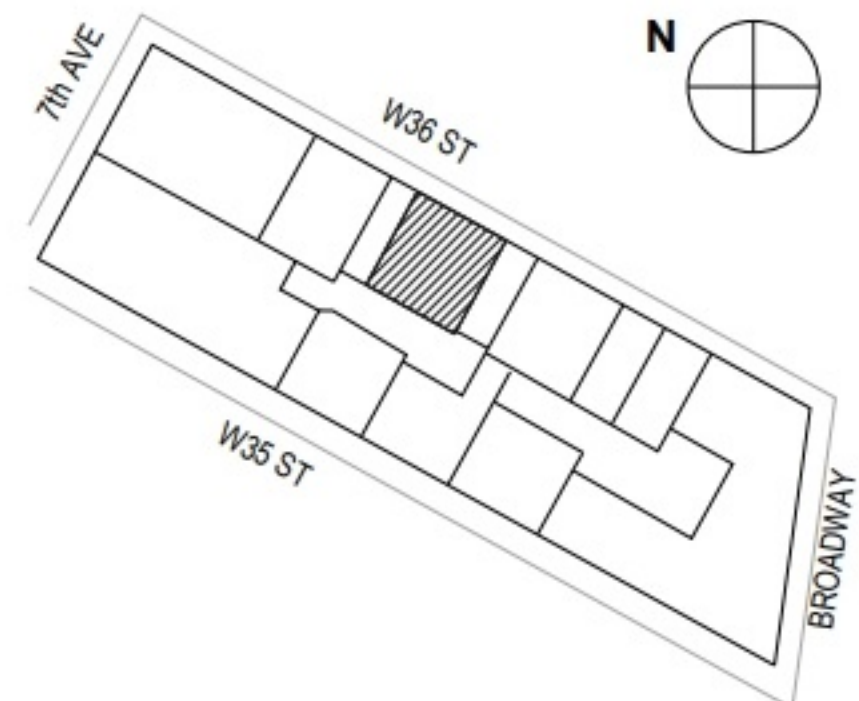

DRAWING TITLE:
14th FLOOR - AS BUILT PLAN

PROJECT #: 2306107

SEAL & SIGNATURE:

DATE:	07/07/2023
SCALE:	AS SHOWN
DRAWN BY:	LD
CHECKED BY:	FG
DESIGN BY:	THREESTUDIO
SHEET NO.	

A-114.00