


E 57TH ST



MADISON AVE

KEY PLAN:

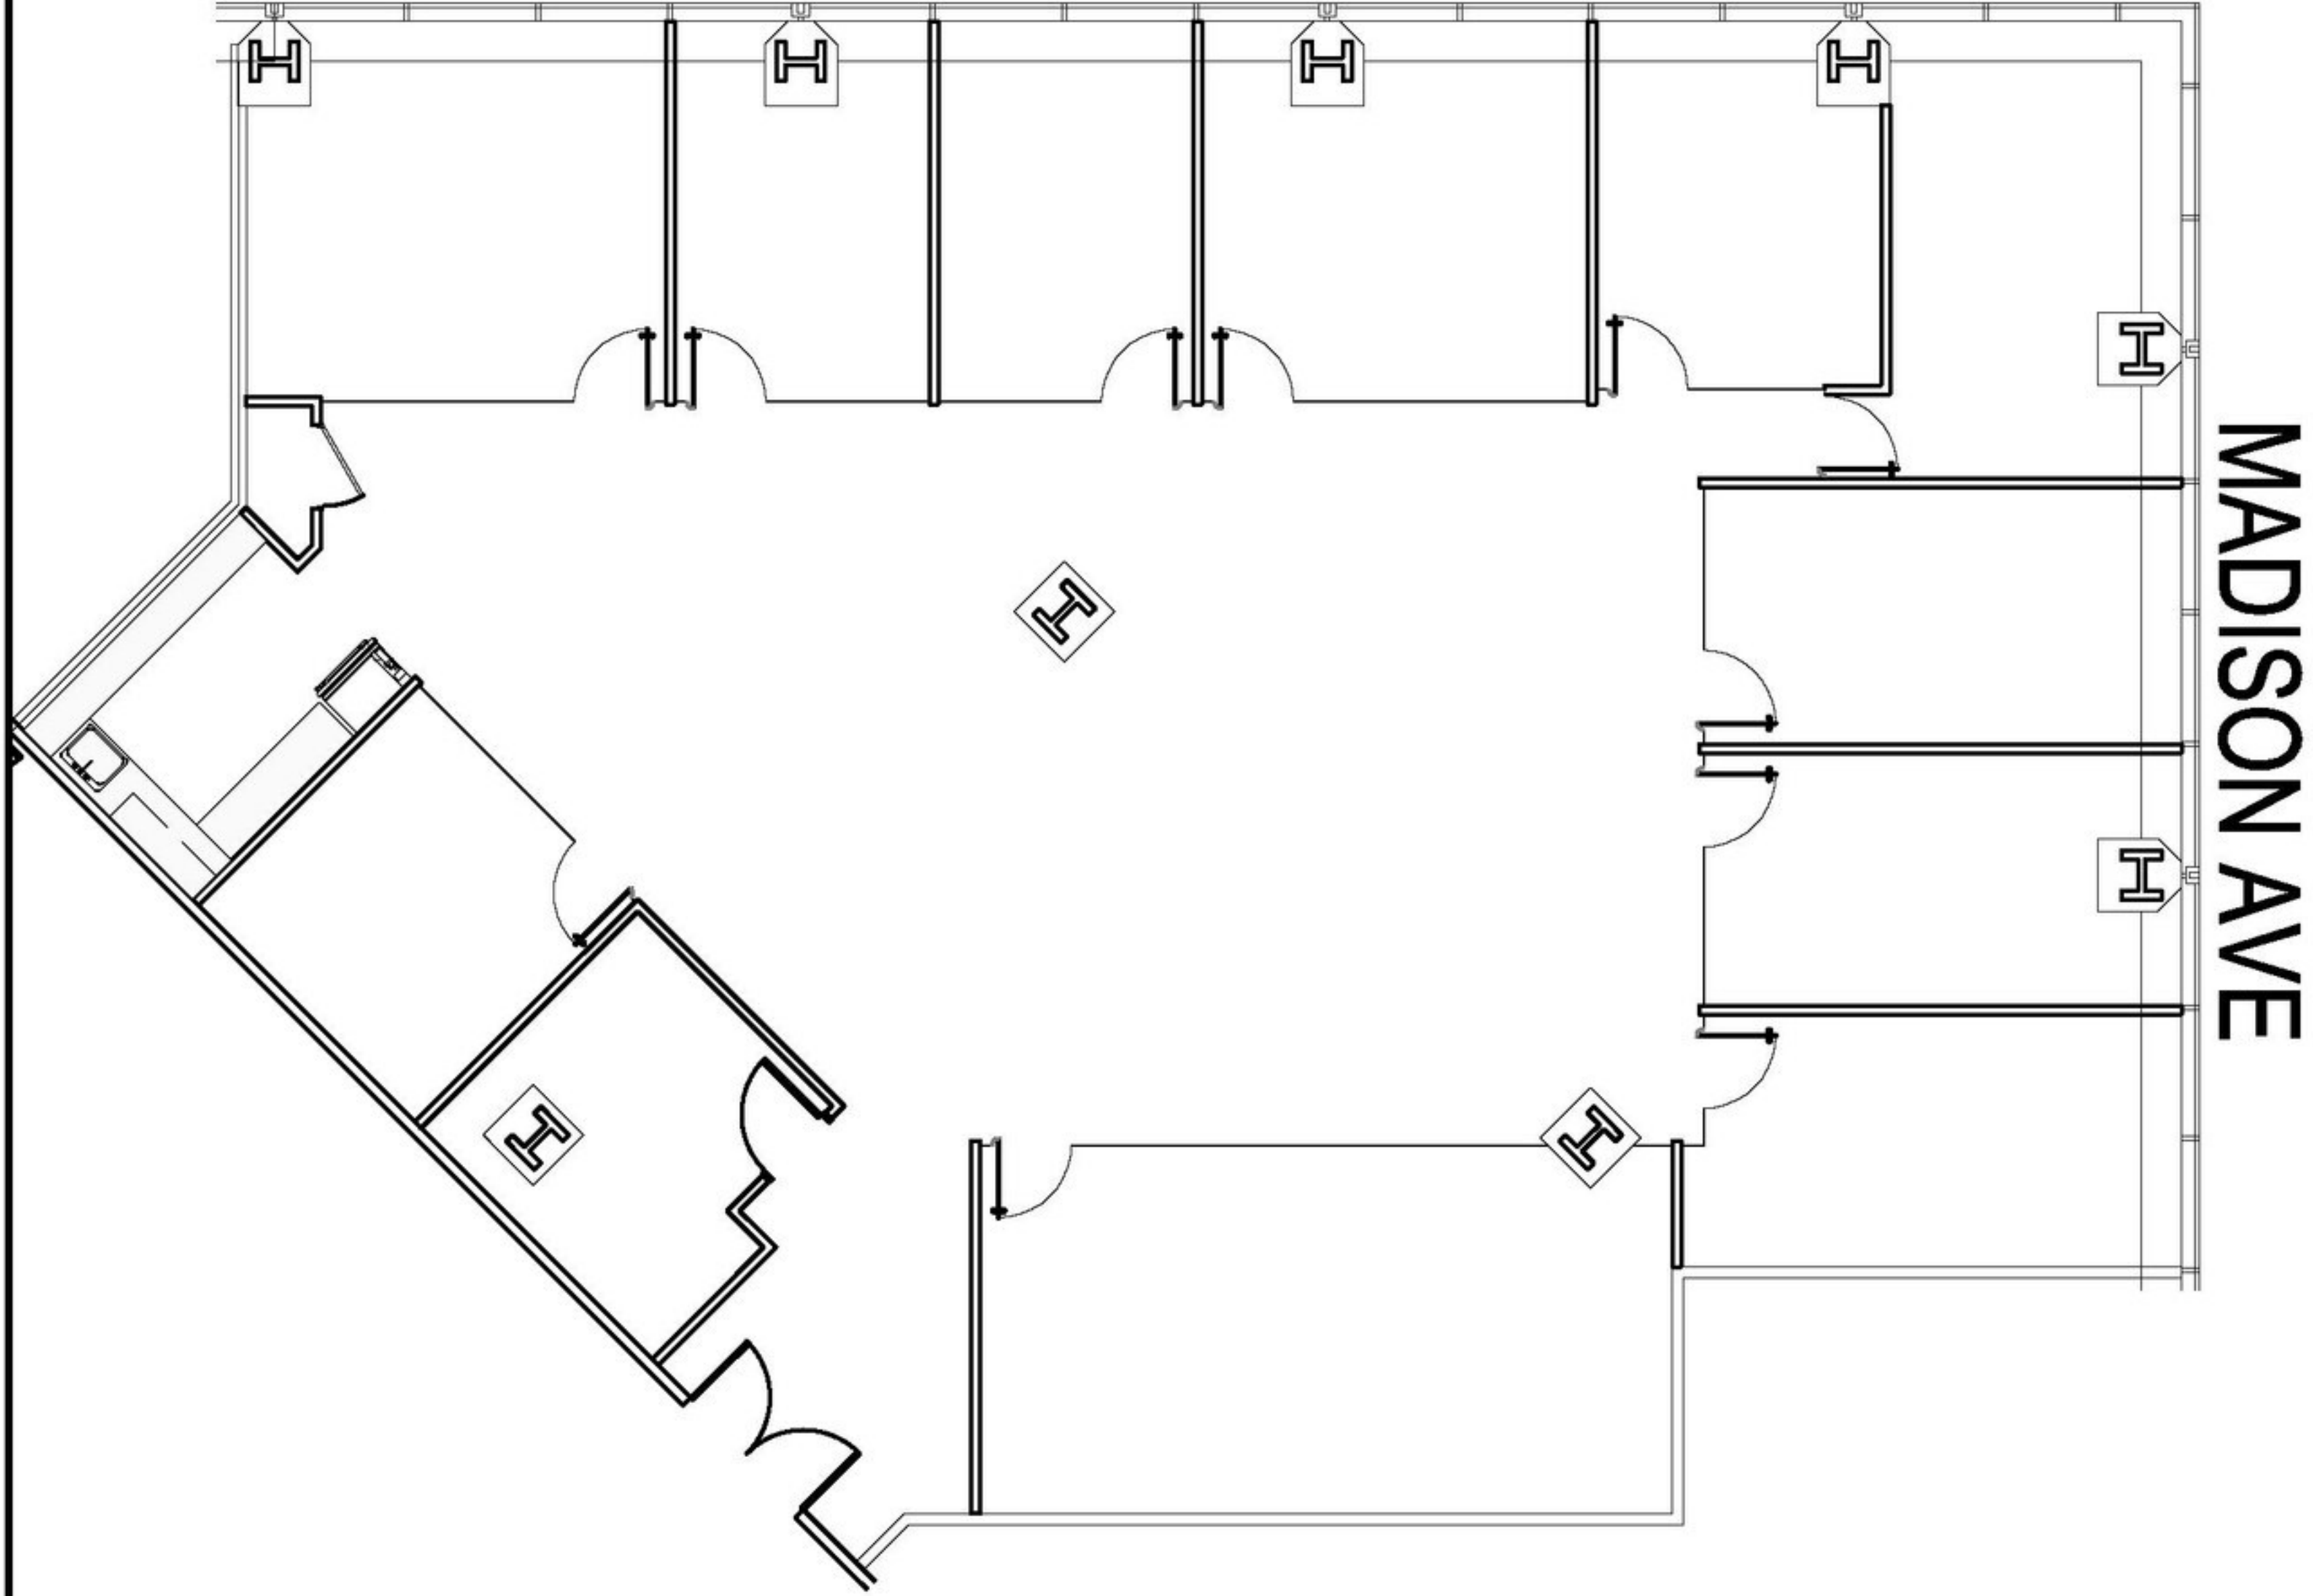

E 56TH ST
SCALE: N.T.S.

AS-BUILT PLAN
SUITE 2703

FLOOR 27
590 MADISON AVENUE
NEW YORK, NEW YORK

PROJECT LOCATION	
FILE NAME	PLAT DATE
DATE	APR 28, 20
DRAWN BY	chove
DRAWING NO. AB-1	