



Entire 5th Floor As-Built Furniture Plan – 6,533 RSF

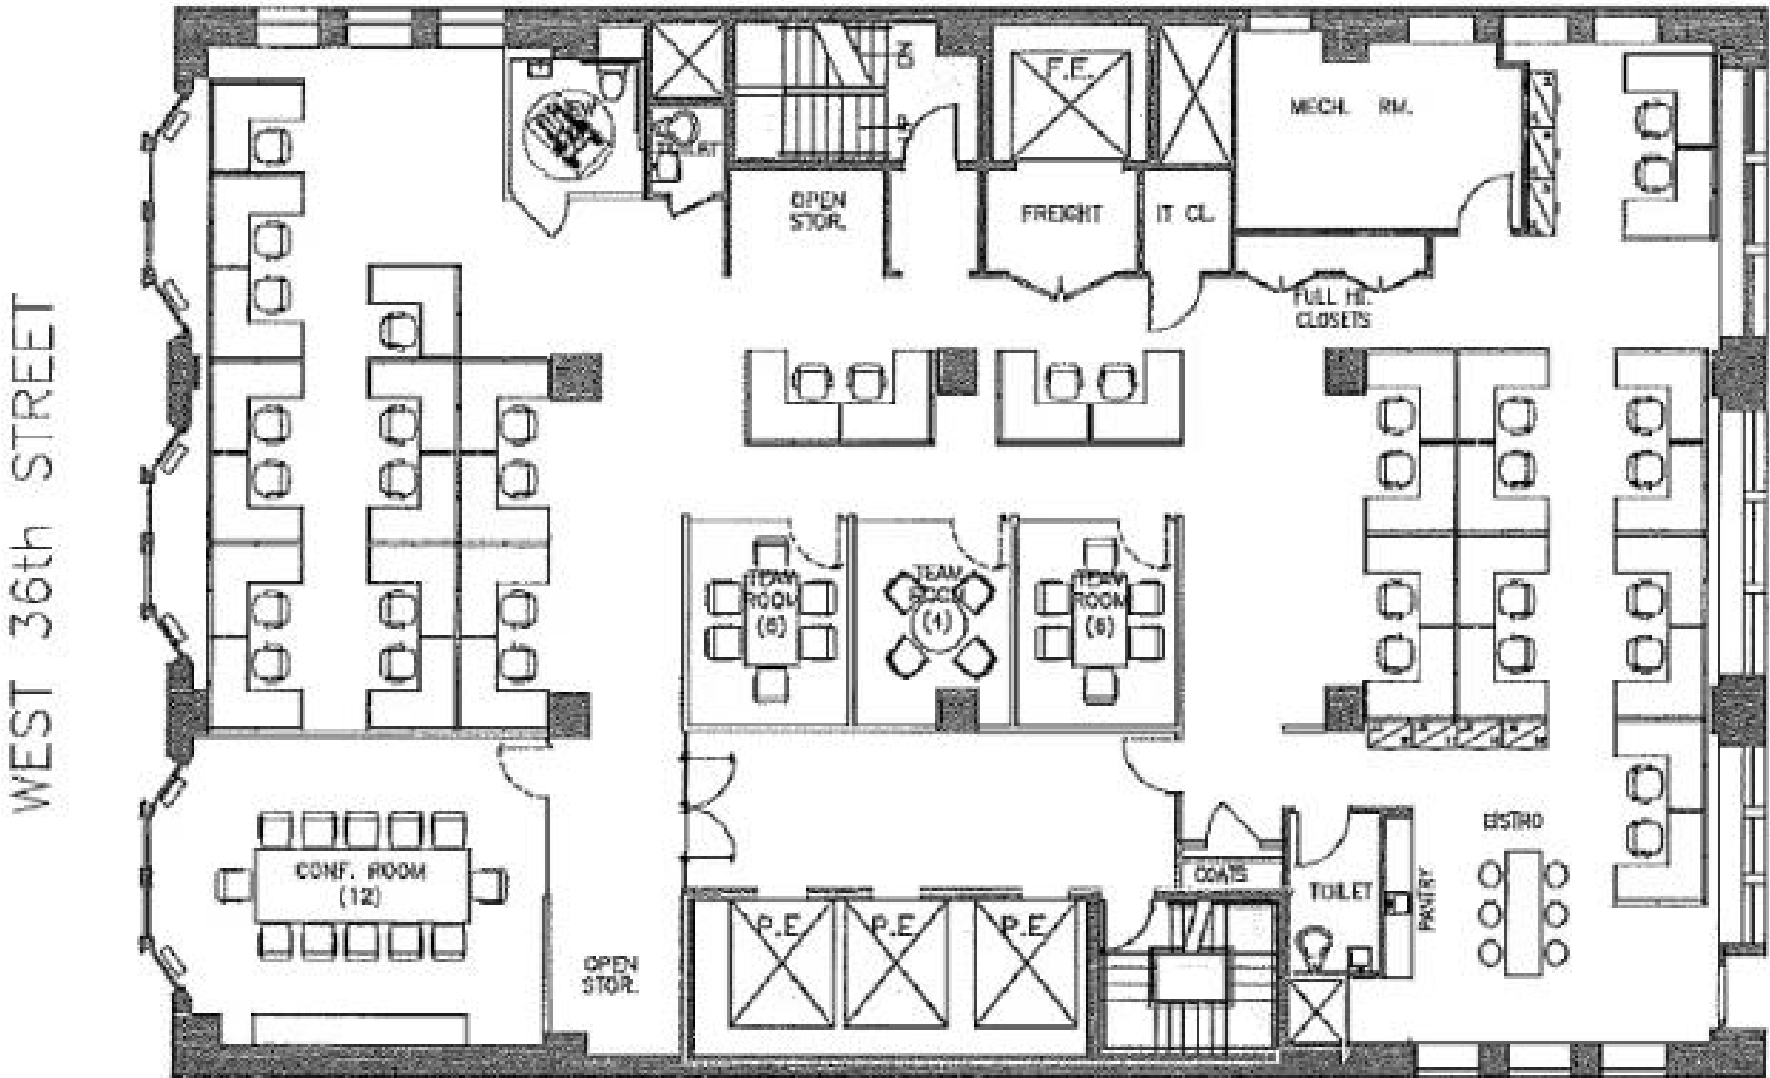

LEGEND	
WORKSTATIONS (6x8)	38
TOTAL	38

CONFERENCE ROOM (12)	1
TEAM ROOM (6)	2
TEAM ROOM (4)	1
IT CLOSET	1
PAINTY	1
OPEN STORAGE	2
COAT CL.	1

WEST 36TH STREET

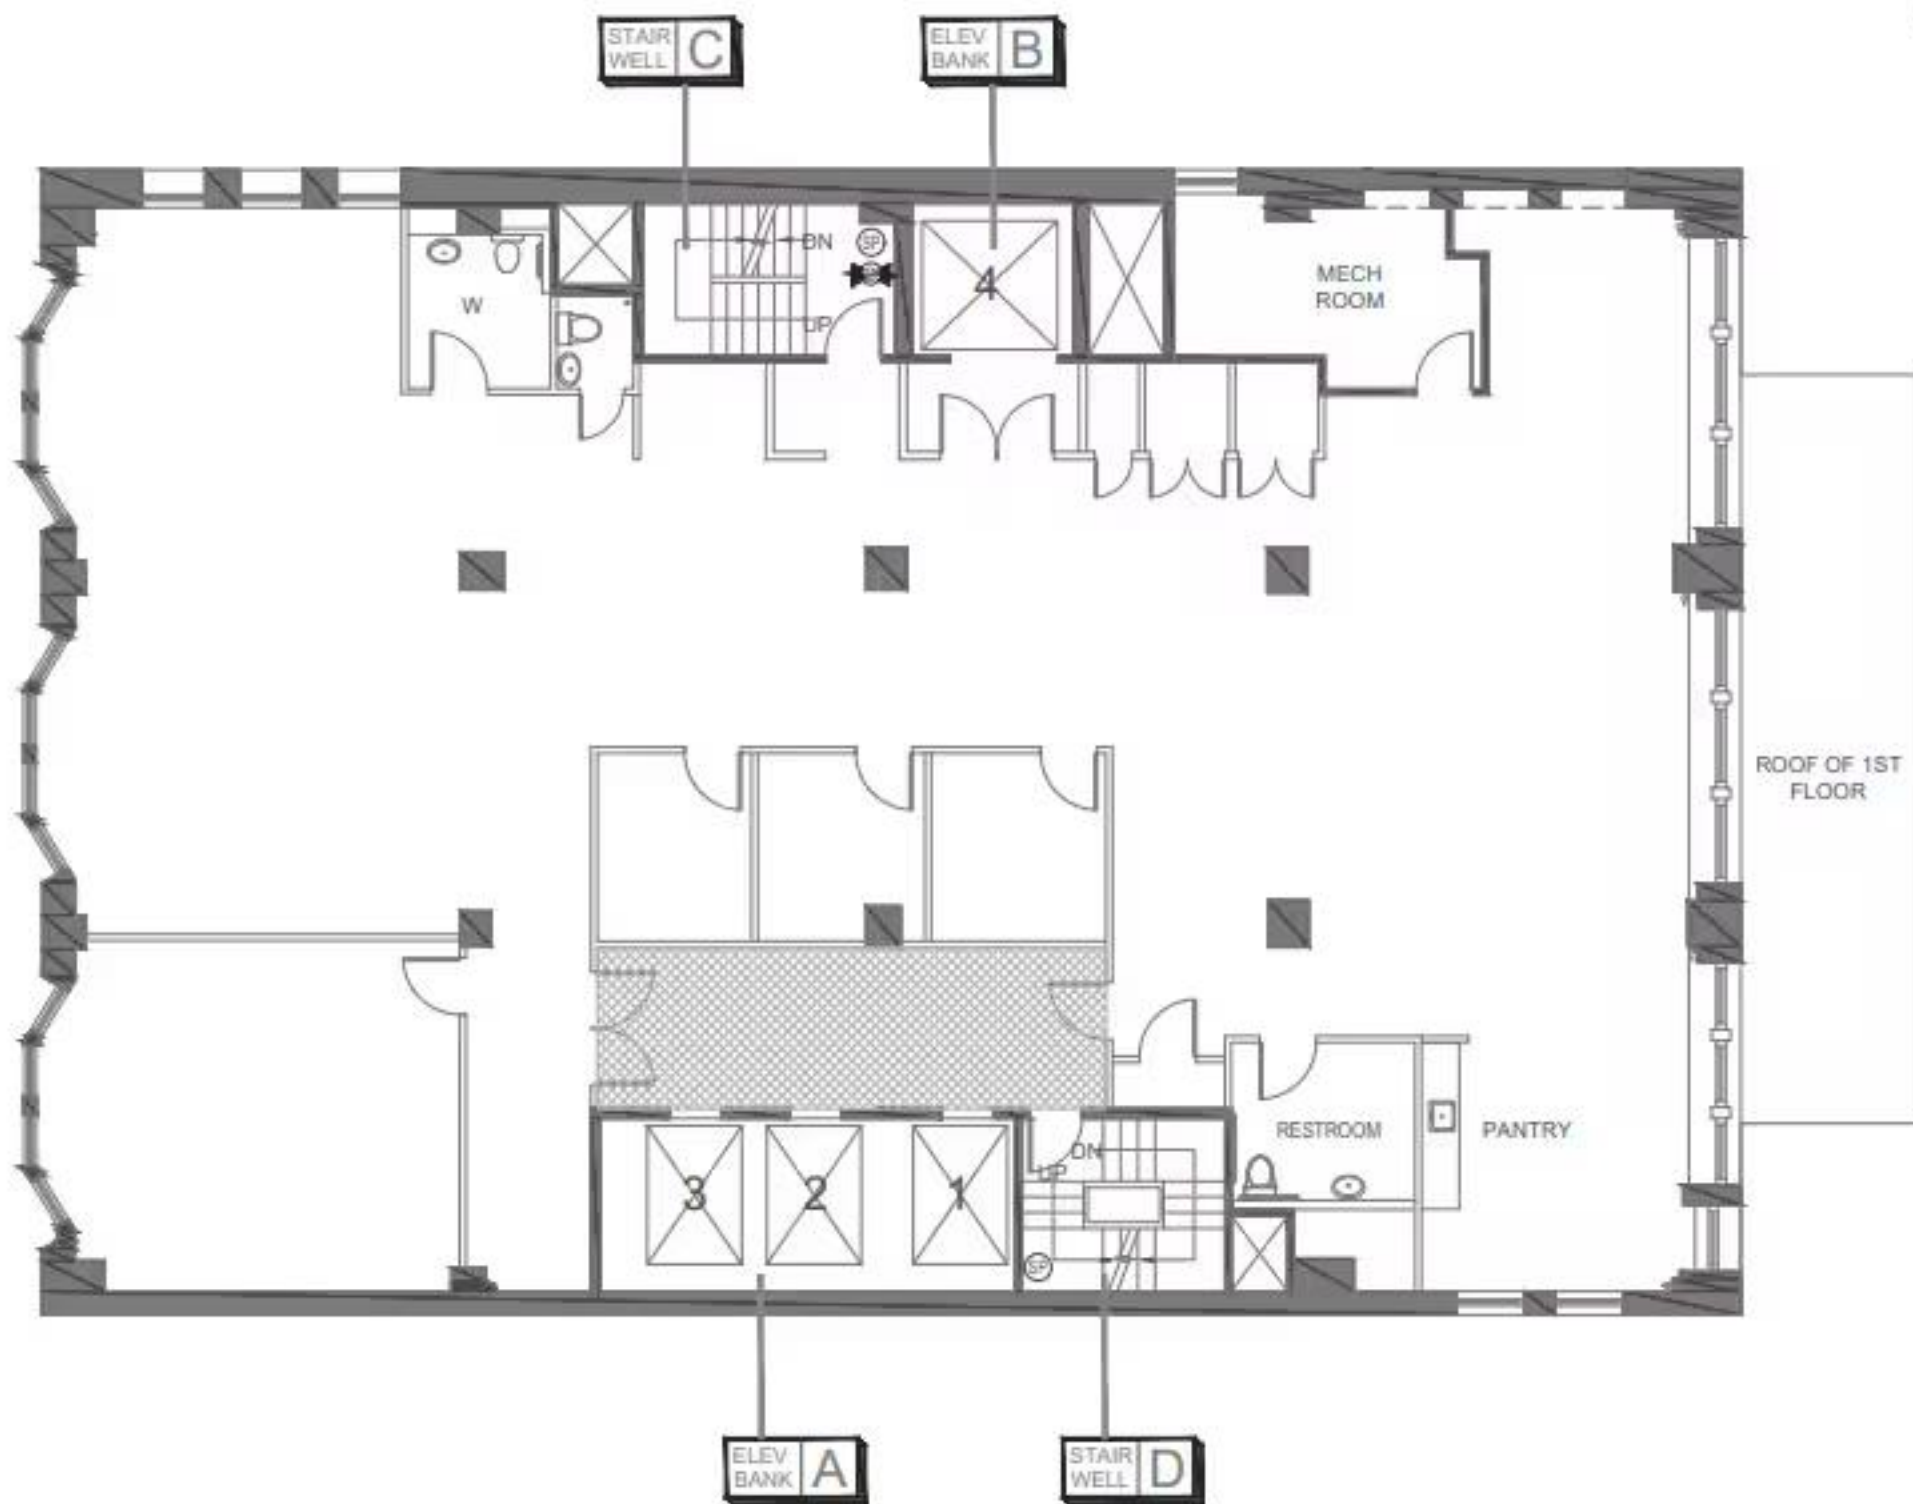

LEGEND

- SP STANDPIPE HOSE OUTLET
- FIRE ALARM CONTROL PANEL
- FIRE DEPT. CONNECTION (SIAMESE CONNECTION)
- STANDPIPE CONTROL VALVE
- SPRINKLER CONTROL VALVE
- DOMESTIC WATER MAIN CONTROL VALVE
- EVACUATION ROUTE
- FURNITURE/EQUIPMENT
- NON-RATED PARTITION
- FIRE BARRIER
- IN-BUILDING RELOCATION AREAS (IBRA)

NO.	DATE	REVISION	REVISION DESCRIPTION
1	06/28/22	JG	ISSUED FOR REVIEW
2	07/06/22	JG	ISSUED FOR REVIEW
3	07/07/22	JG	ISSUED FOR REVIEW

DRAWN BY/DATE: JG / 06.22.22
 CHECKED BY/DATE: DL / 7.28.22

BUILDING ADDRESS:
 141 WEST 36TH STREET
 NEW YORK, NY 10018

DRAWING TITLE:
FL-5
5TH FLOOR

SURVEY BY: JG
 SURVEY DATE(S): 06.21.22

NOTES:
 FULL SPRINKLER COVERAGE