
41 MADISON

Floor 33 As Built Plan

9,096 Sq. Ft. Partial Floor Available

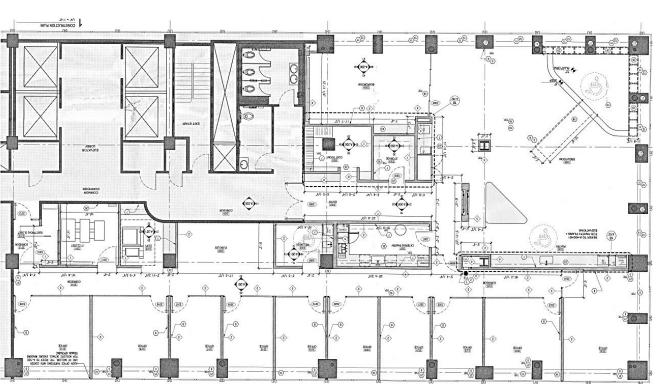

East 26th Street