

PARTIAL


19

9,533 RSF

As-Built

SPACE SUMMARY

Offices	11
Open Area	30
Conference Room	1
Multipurpose Room	1
Pantry	1
IT Room	1

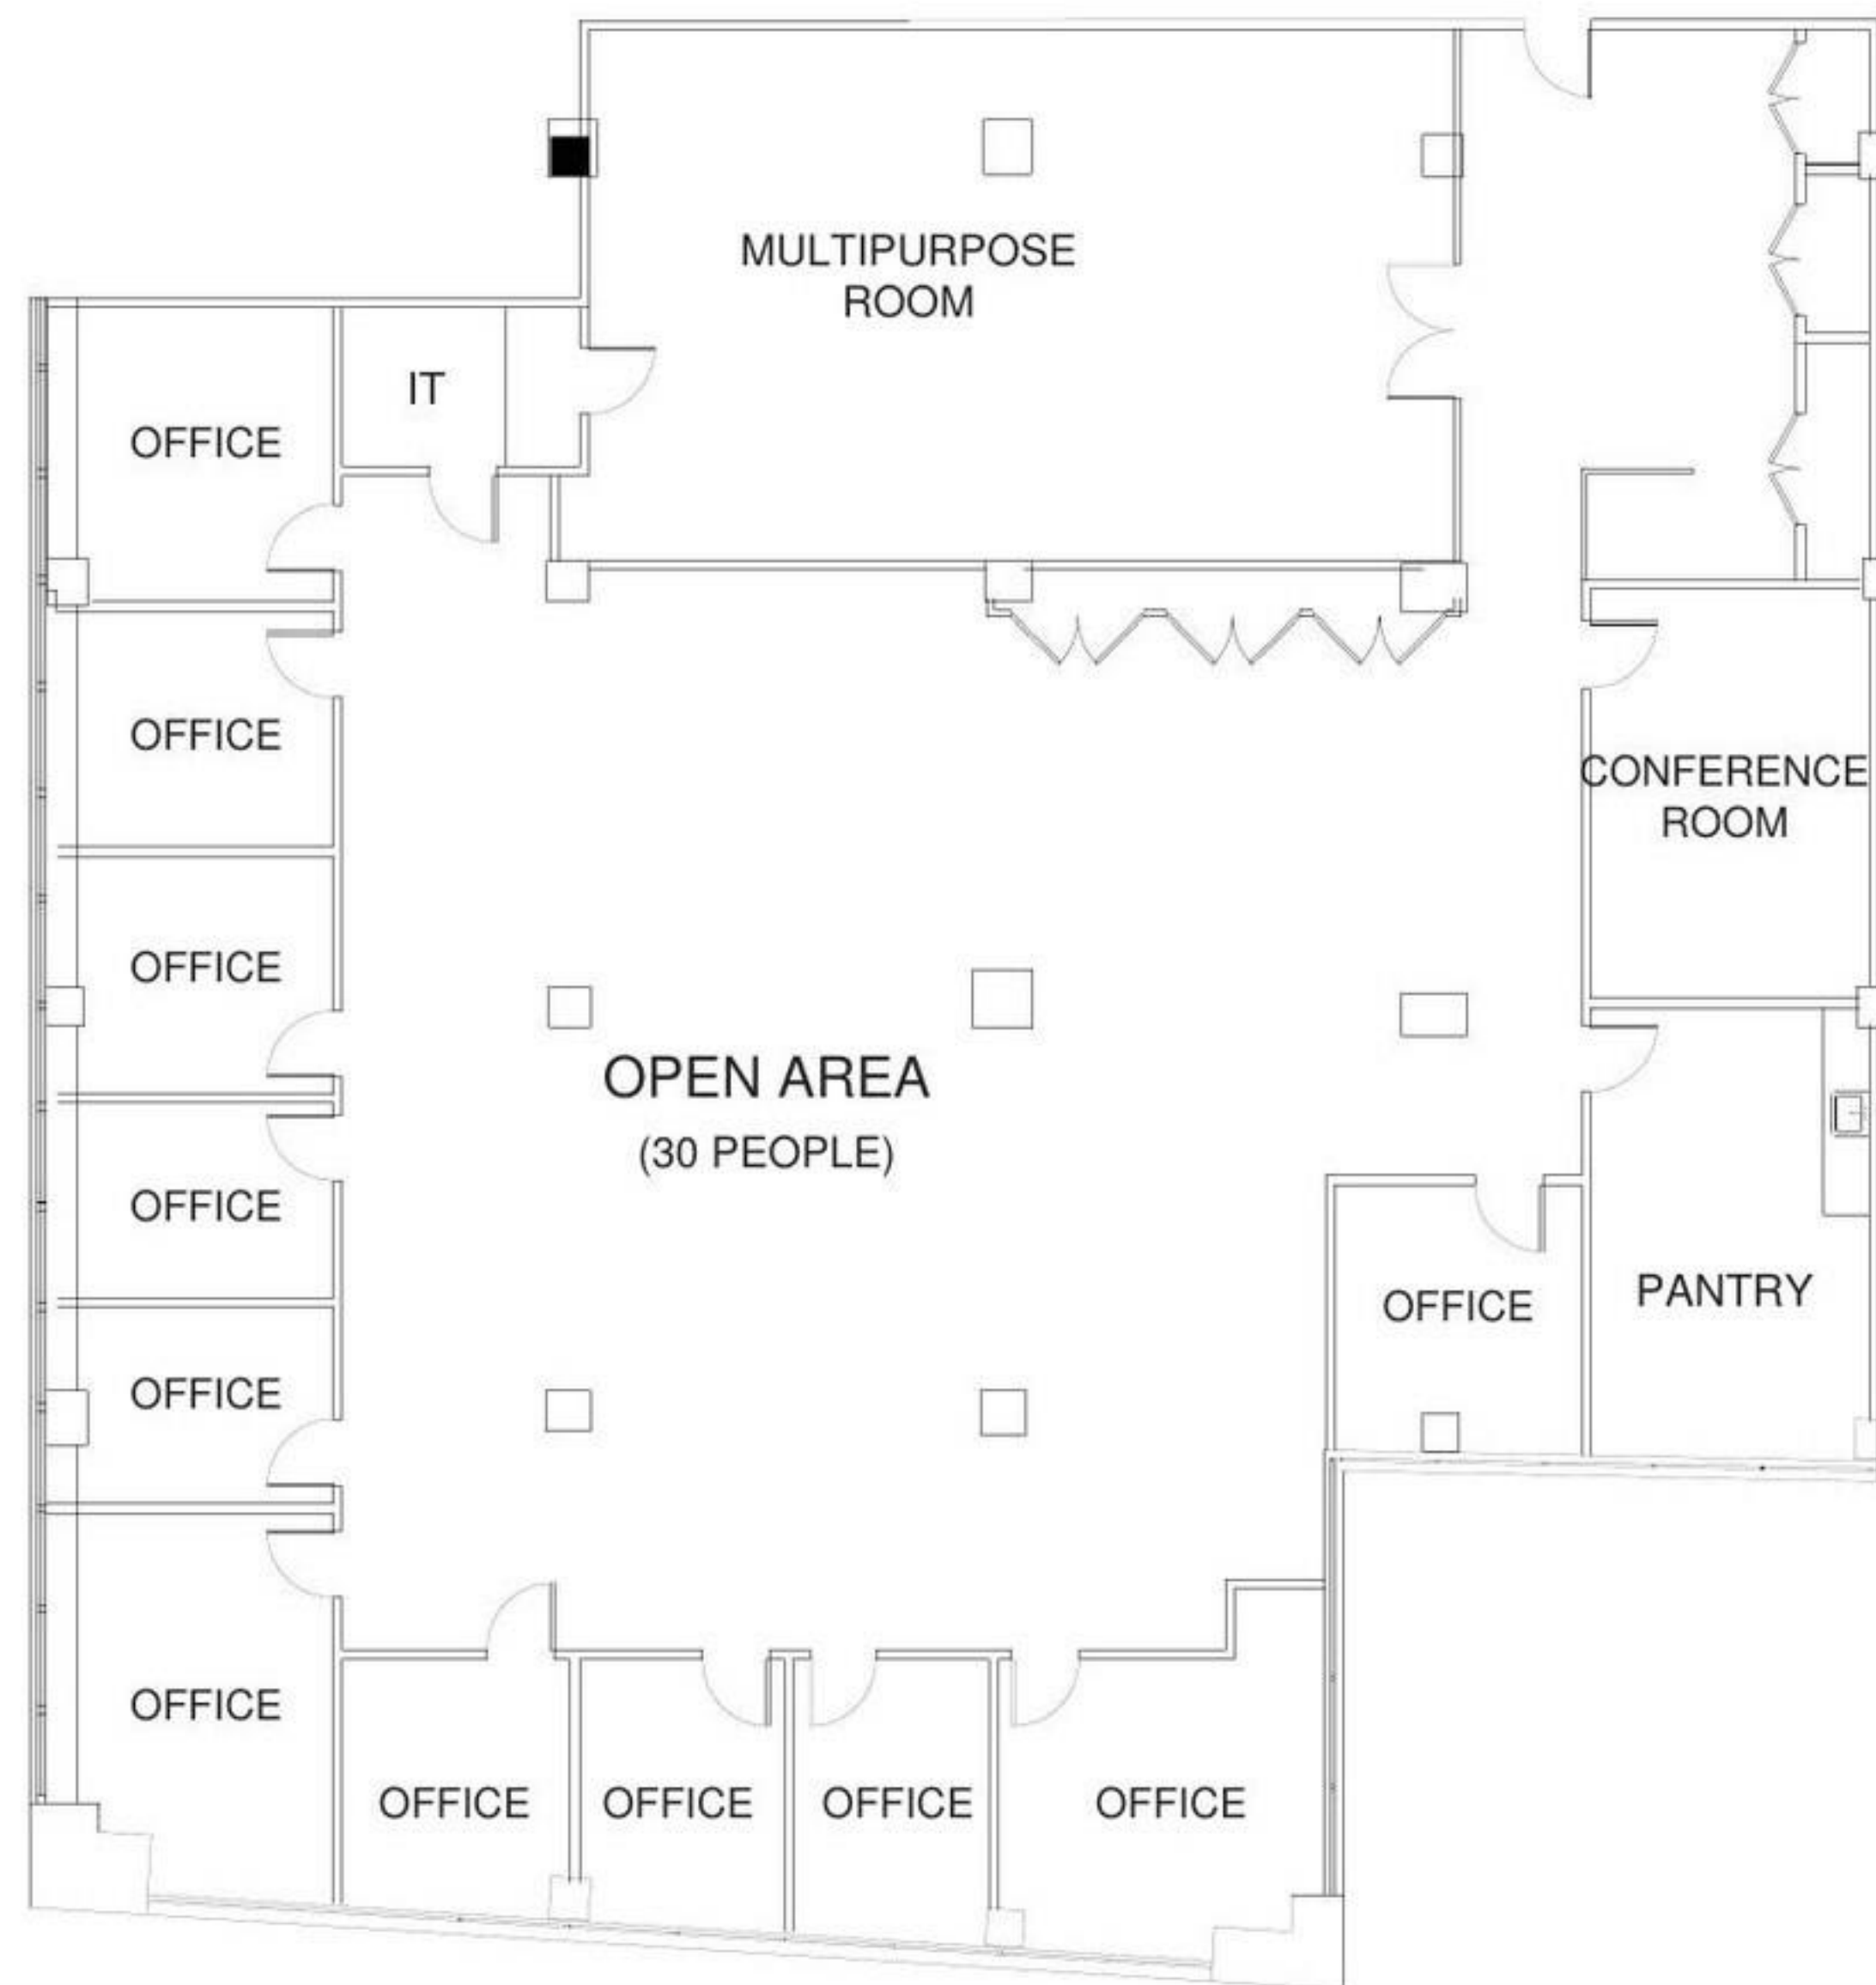

123 WILLIAM STREET