

# TOWER56


PLAZA DISTRICT | 126 E 56

Suite 1000

As-Built

3,774 RSF

- 6 Offices
- 3-4 Open Area
- 1 Conference Room
- 1 Pantry

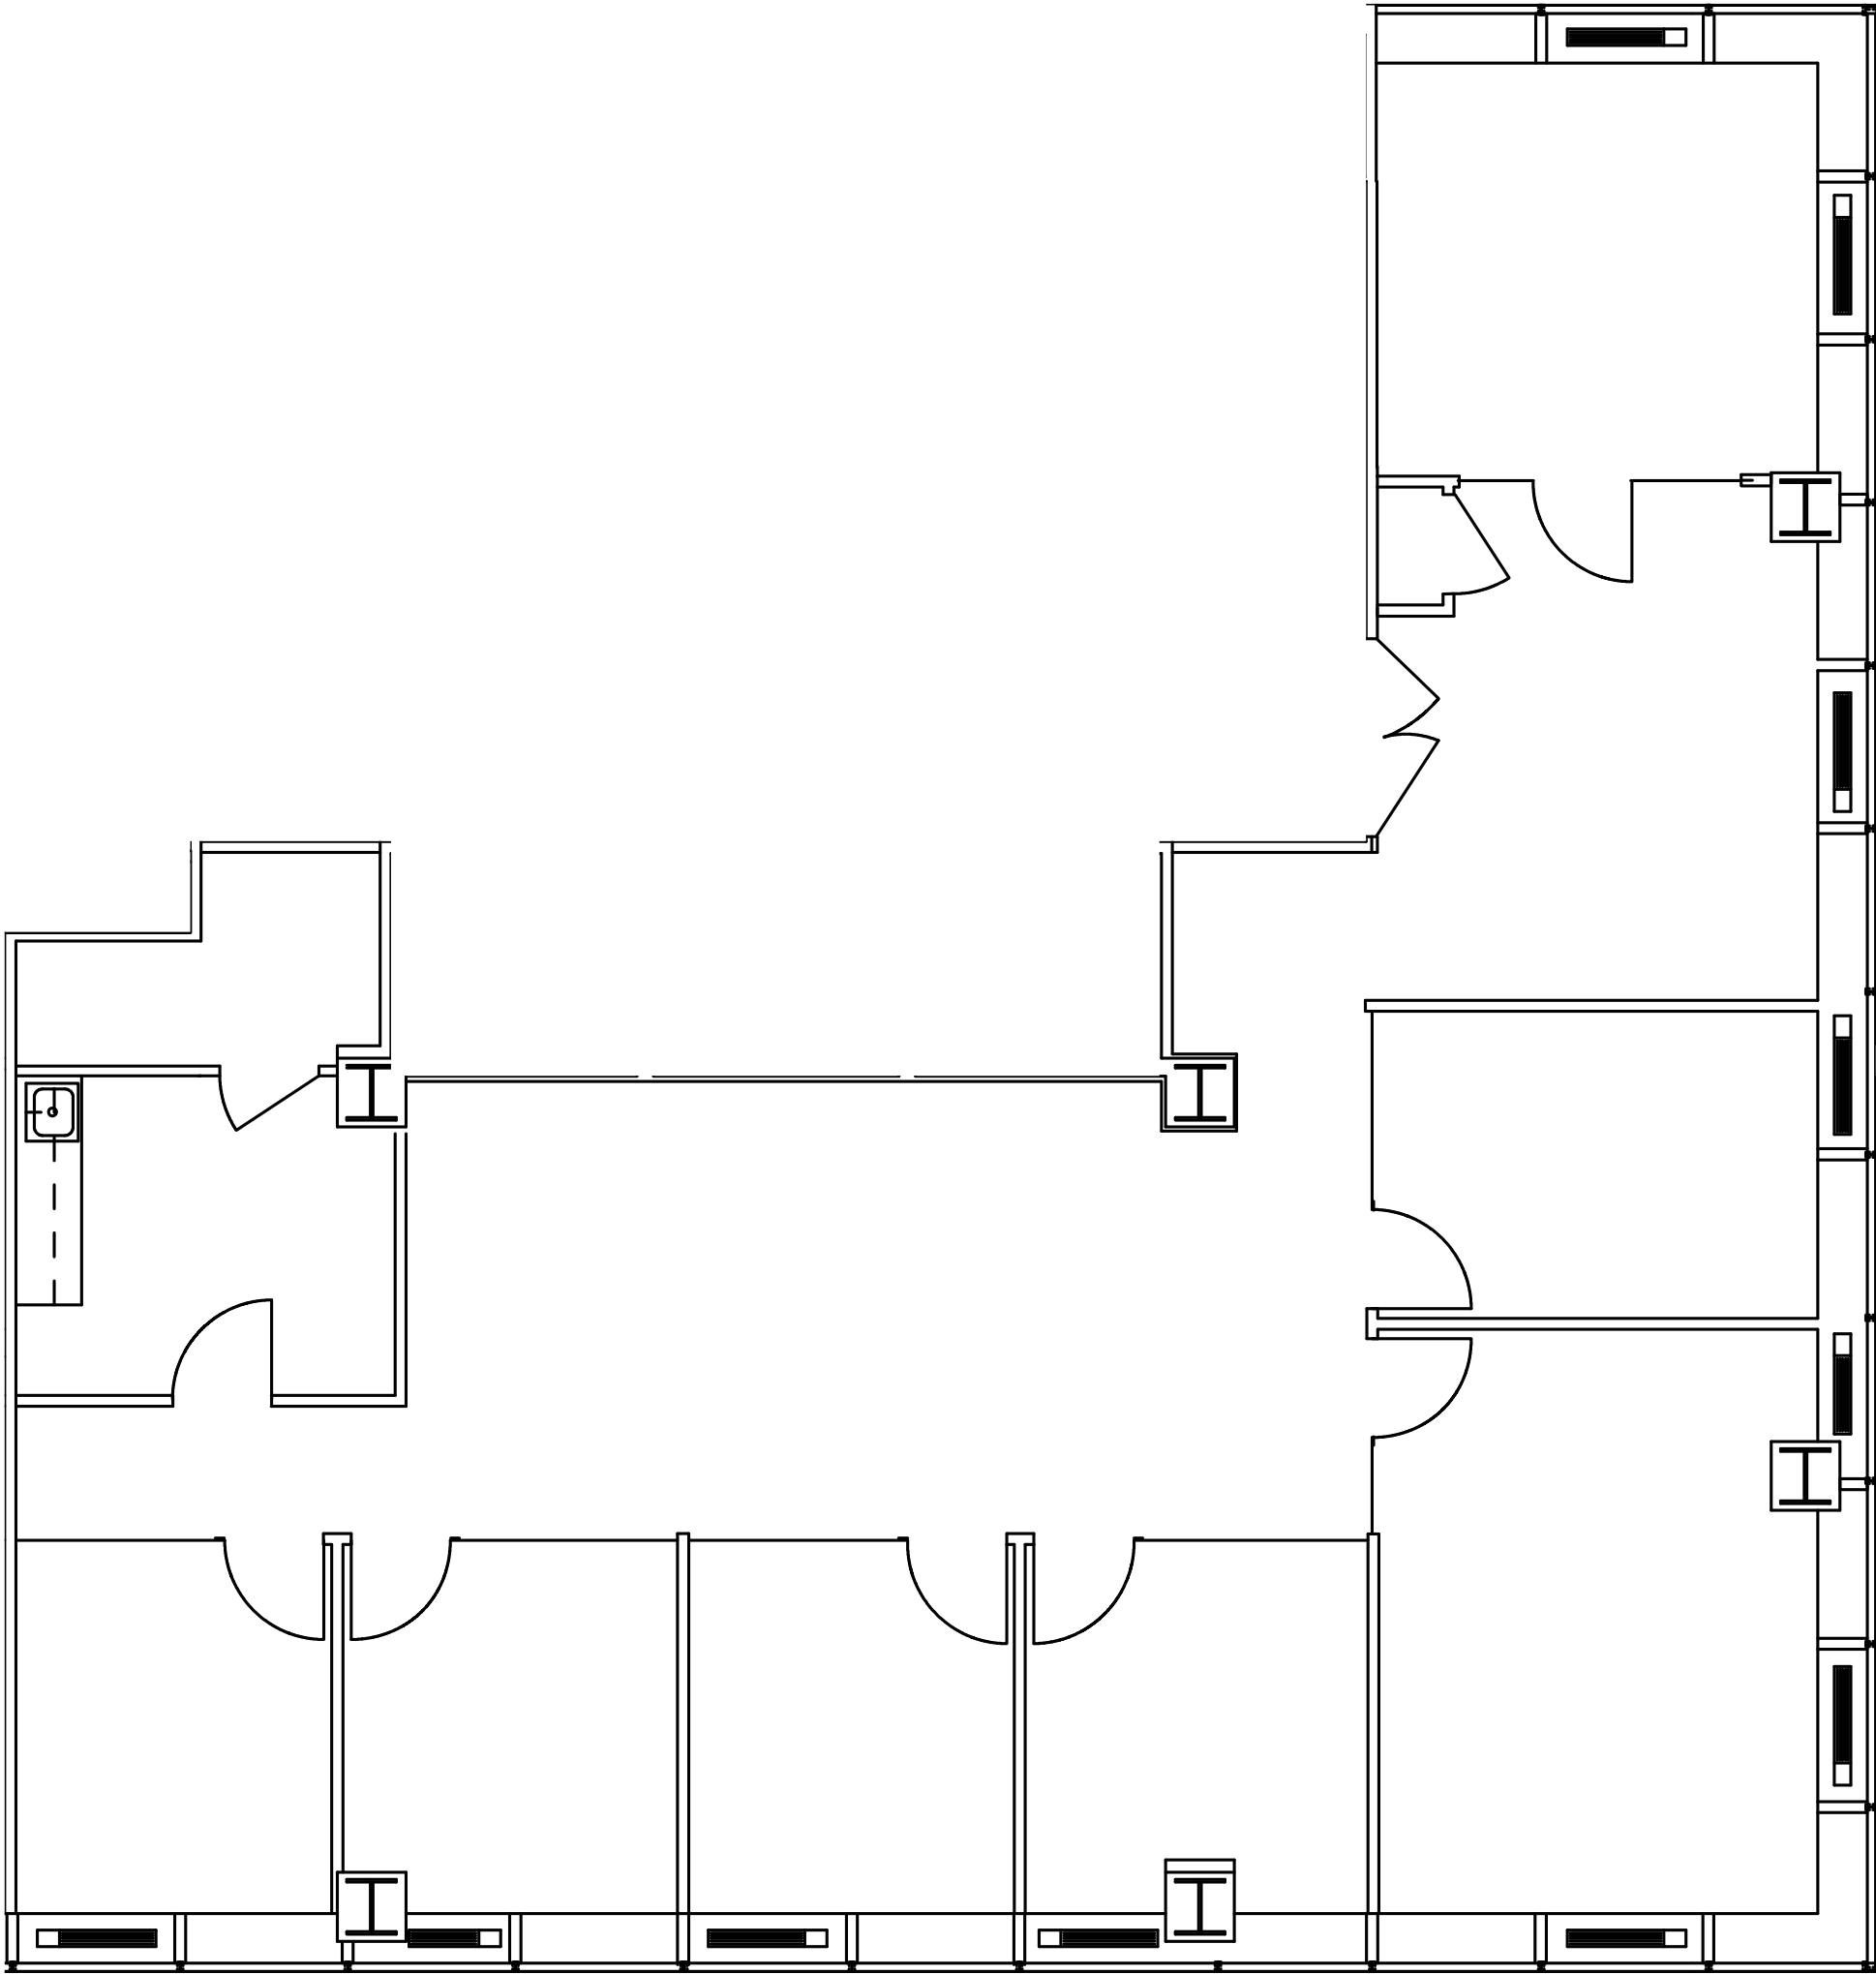

East 56th Street

