

655 THIRD AVENUE

PARTIAL FLOOR 29
3,931 SF



BUILDING EXTERIOR



BUILDING LOBBY

AVAILABILITY


- Built Corner Office
- Superb Midtown Views
- Available Q1 2022

PROPERTY FEATURES

- Renovated lobby includes a new concierge desk, newsstand, and turnstiles
- Green roofs and exclusive outdoor terraces
- LEED Gold certified under LEED v4 Existing Buildings: Operations + Maintenance

AS-BUILT PLAN

East 42nd Street

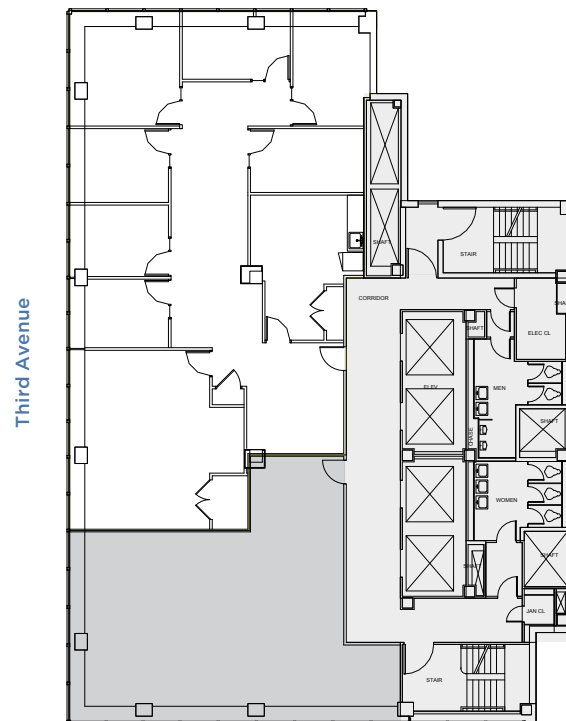

East 41st Street