

655 THIRD AVENUE

ENTIRE FLOOR 24
5,719 SF



CONFERENCE ROOM



PRIVATE OFFICE

AVAILABILITY


- High-End Built & Furnished Space
- Bright Light & Sweeping Views

PROPERTY FEATURES

- Renovated lobby includes a new concierge desk, newsstand, and turnstiles
- Green roofs and exclusive outdoor terraces
- LEED Gold certified under LEED v4 Existing Buildings: Operations + Maintenance

AS-BUILT PLAN

East 42nd Street

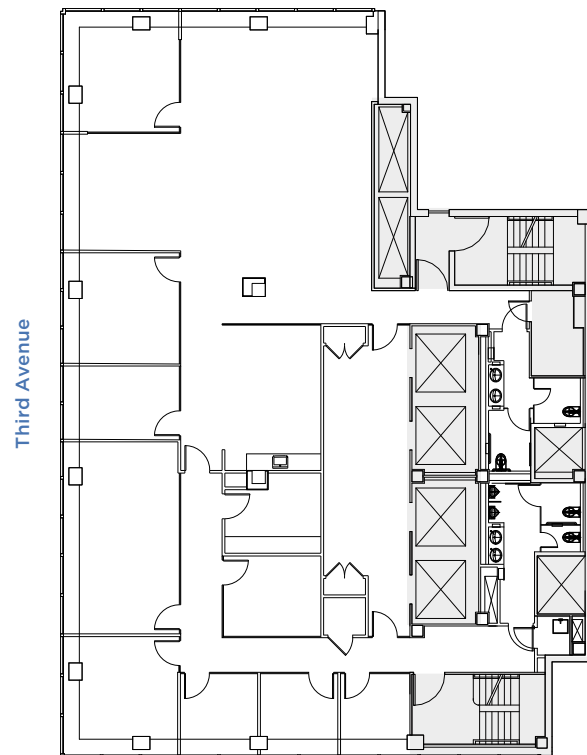

East 41st Street