

655 THIRD AVENUE

PARTIAL FLOOR 15
8,531 SF



BUILDING EXTERIOR



BUILDING LOBBY

AVAILABILITY


- Built Corner Unit
- Arranged Possession

PROPERTY FEATURES

- Renovated lobby includes a new concierge desk, newsstand, and turnstiles
- Green roofs and exclusive outdoor terraces
- LEED Gold certified under LEED v4 Existing Buildings: Operations + Maintenance

AS-BUILT PLAN

East 42nd Street

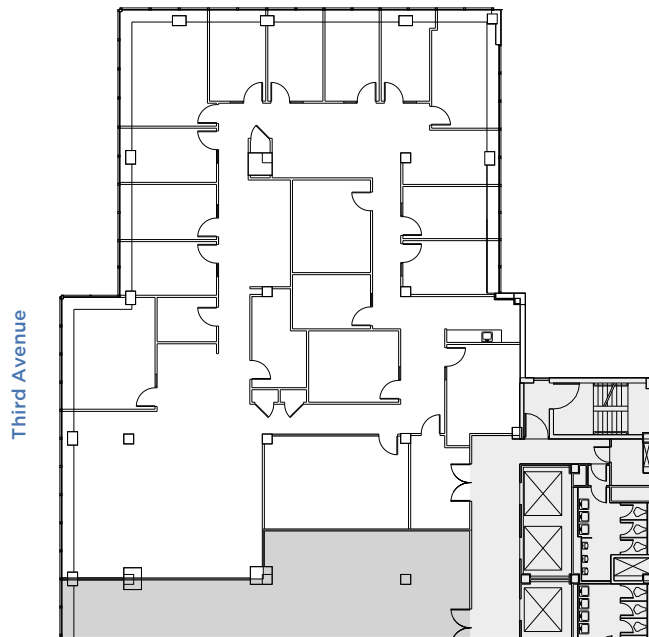

East 41st Street

