
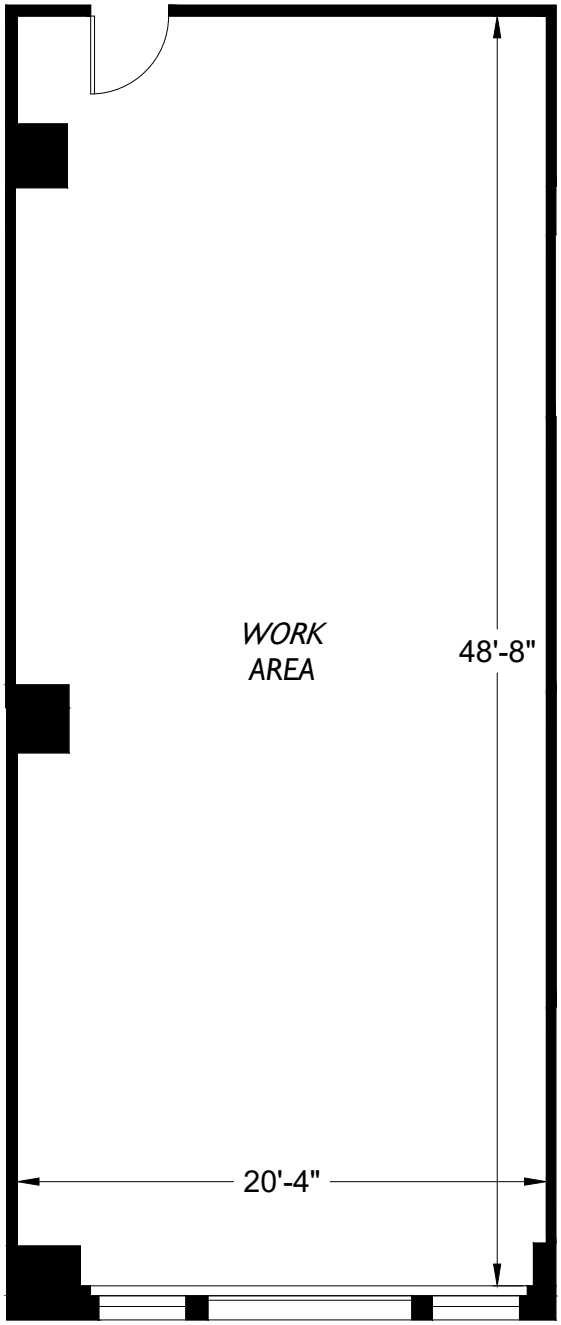


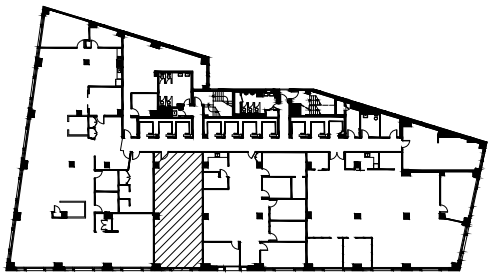

2-D
AS-BUILT
FLOOR PLANS

111 JOHN STREET
SUITE 240
NEW YORK, N.Y.