41 MADISON

Floor 30
As-Built Plan

13,857 Sq. Ft.
Entire Floor Available
April 1, 2026

East 26th Street
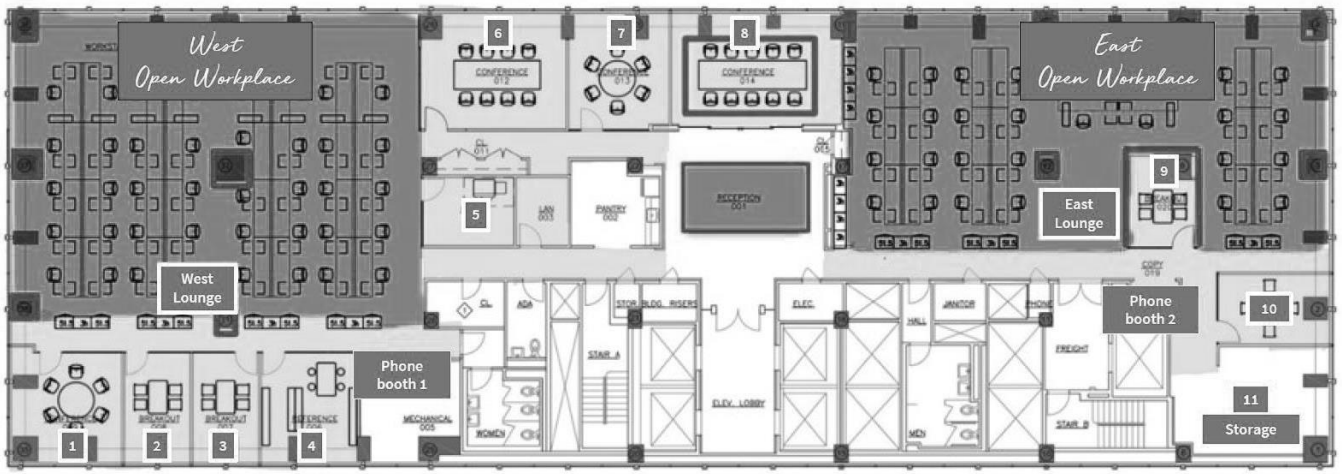
Madison Avenue