


X - - - - wall removed

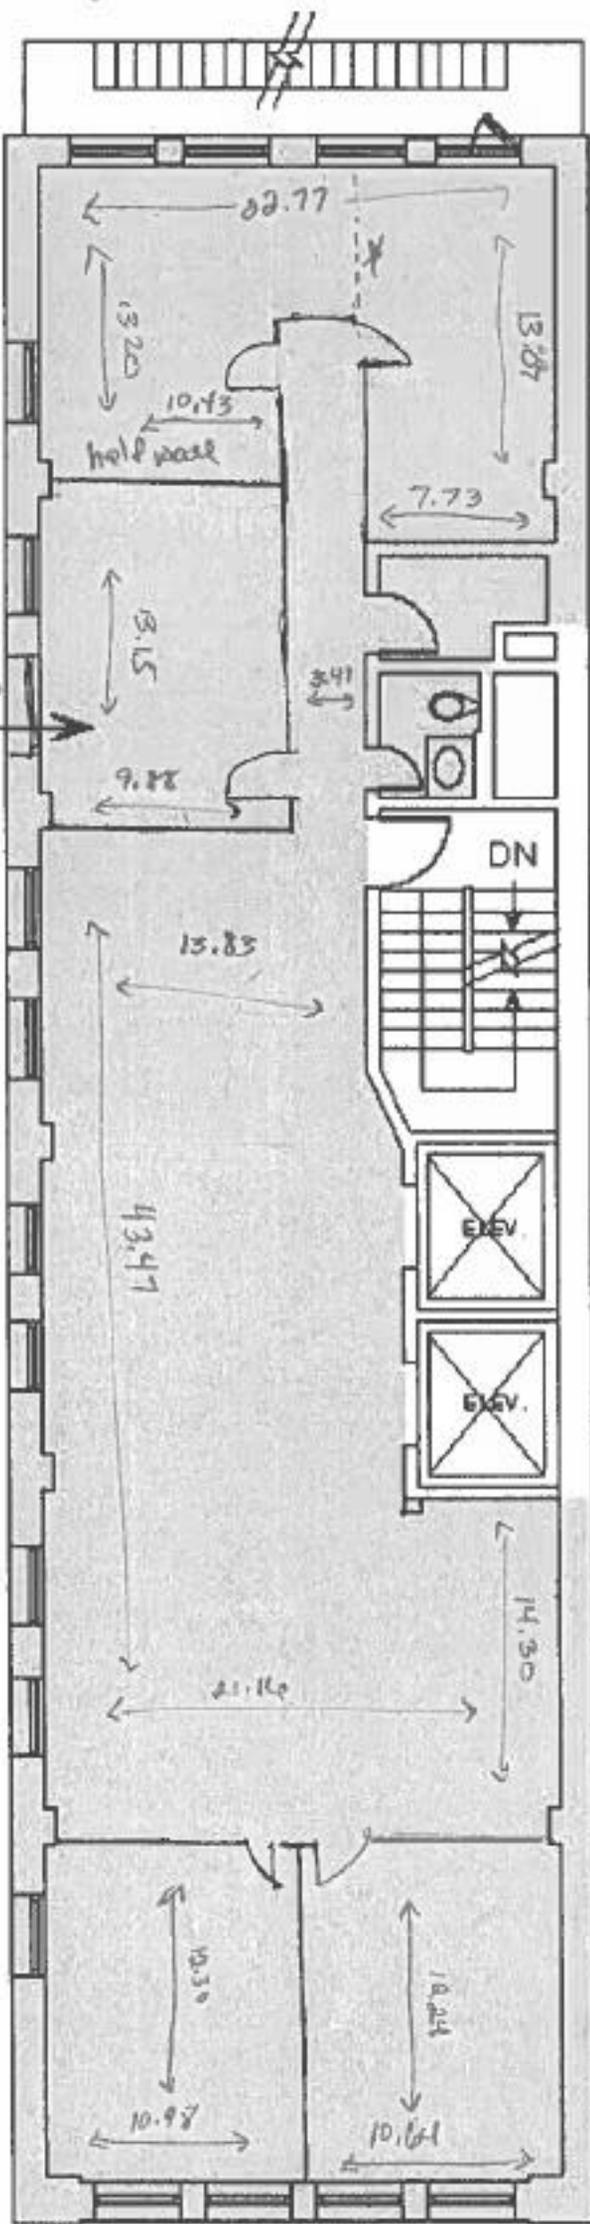

11 W 25 + 8 + 11

add window

2,500 RSF