


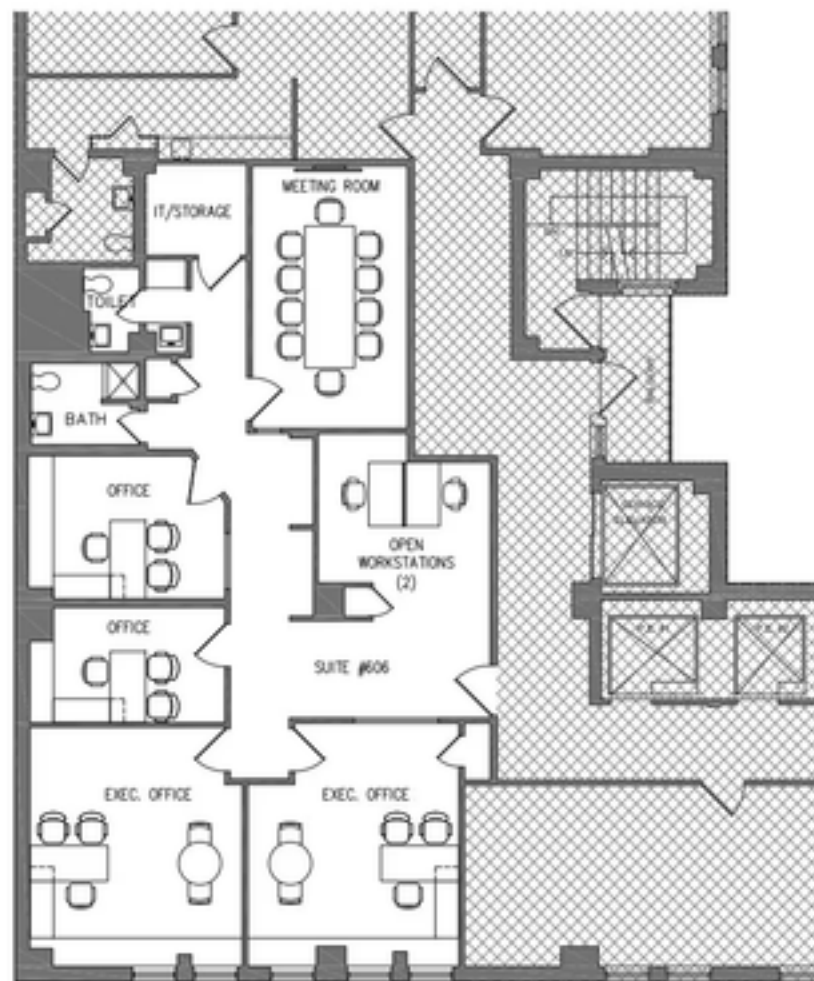

KEY PLAN

37TH STREET

MADISON AVENUE

6TH FLOOR - SUITE #606, AS-BUILT