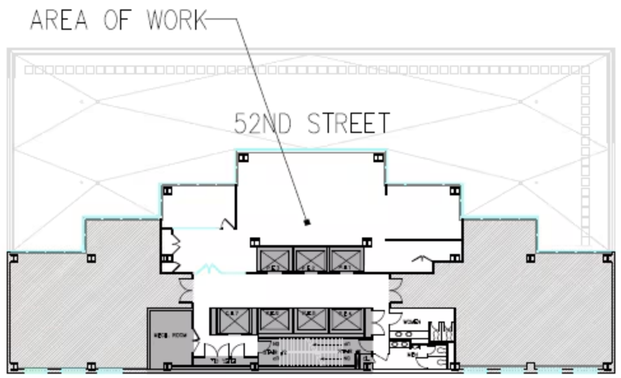


SUITE SUMMARY:
3 OFFICES
10 WORKSTATIONS
2 8-10 PERSON CONFERENCE

RECEPTION
PANTRY
IT CLOSET
COAT CLOSET

0 4 8 16

52ND STREET

8'-9" 13'-8" 13'-6"

12'-0"

18'-5"

OFFICE OFFICE OFFICE

CONFERENCE

10'-7"

6'-4"

2'-5"

COAT CL.

RECEPTION

SUITE B
3,035 RSF

18'-5"

CONFERENCE

13'-6"

3'-6 1/2"

9'-10" 5'-0"

PANTRY

7'-10"

5'-1"

IT CLOSET

AS-BUILT PLAN

150 EAST 52ND STREET
NEW YORK, NY
8TH FLOOR
3,035 RSF