
SevenTwelve
Fifth Avenue

45th Floor

3,160 RSF

Partial Floor
(As Built)

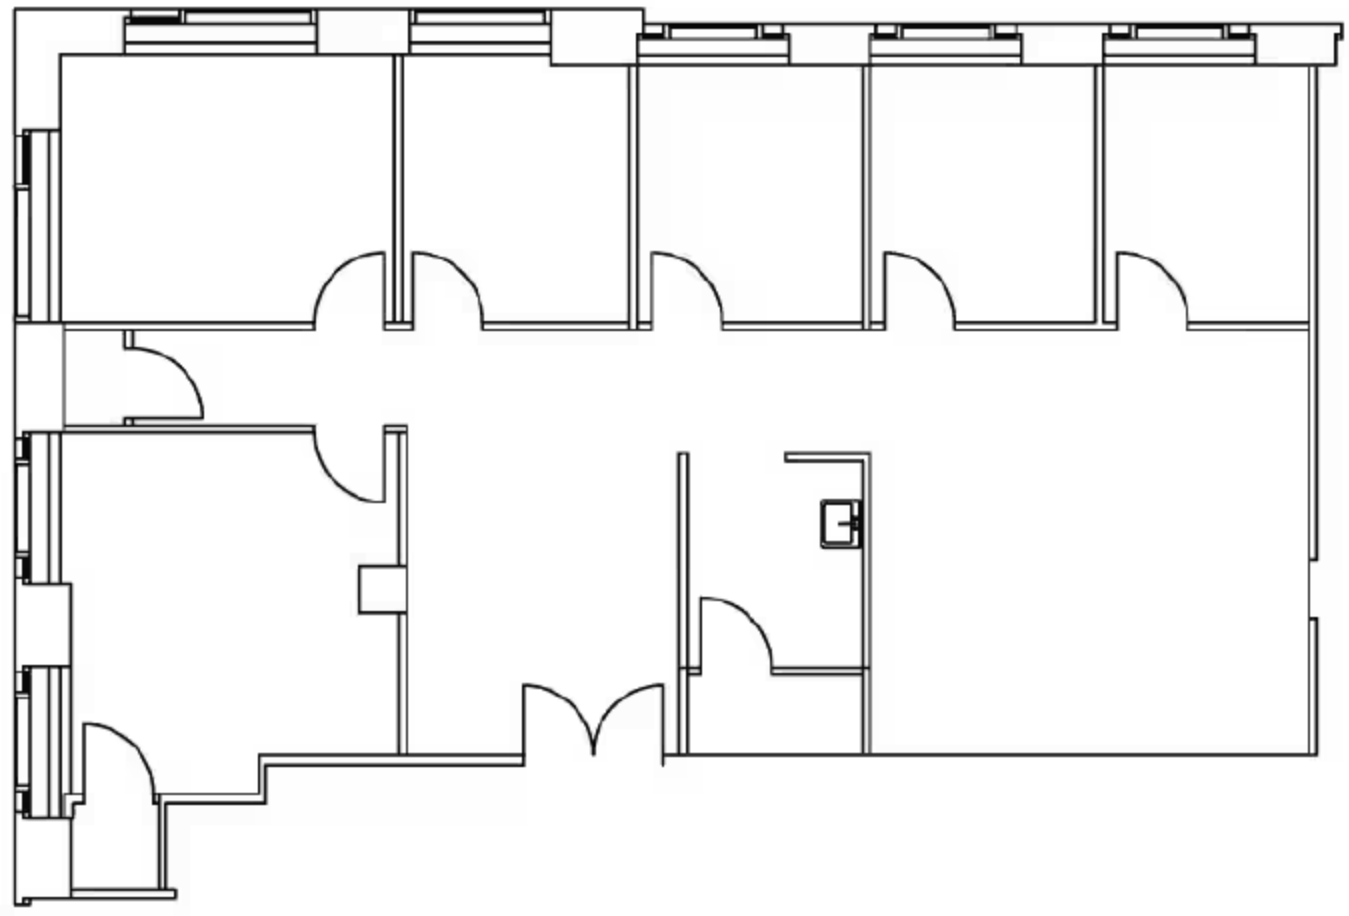

Key Plan

