SUBLEASE



60 Charlton Street





- Move in ready sublease opportunity

- Recently built and furnished installation

- Prime location in newly renovated building



Partial 5th Floor
3,402 RSF

TERM THRU: 4/30/2028
POSSESSION: IMMEDIATE


20
Workstations

2
Office

1
Conference room



As-Built Plan

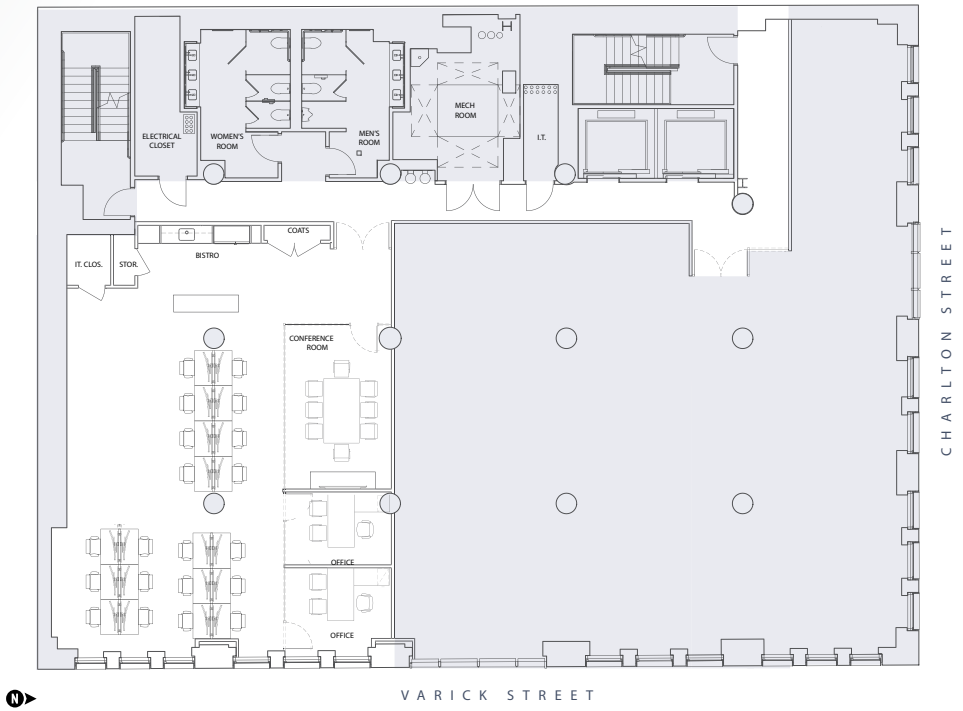

60 Charlton Street