


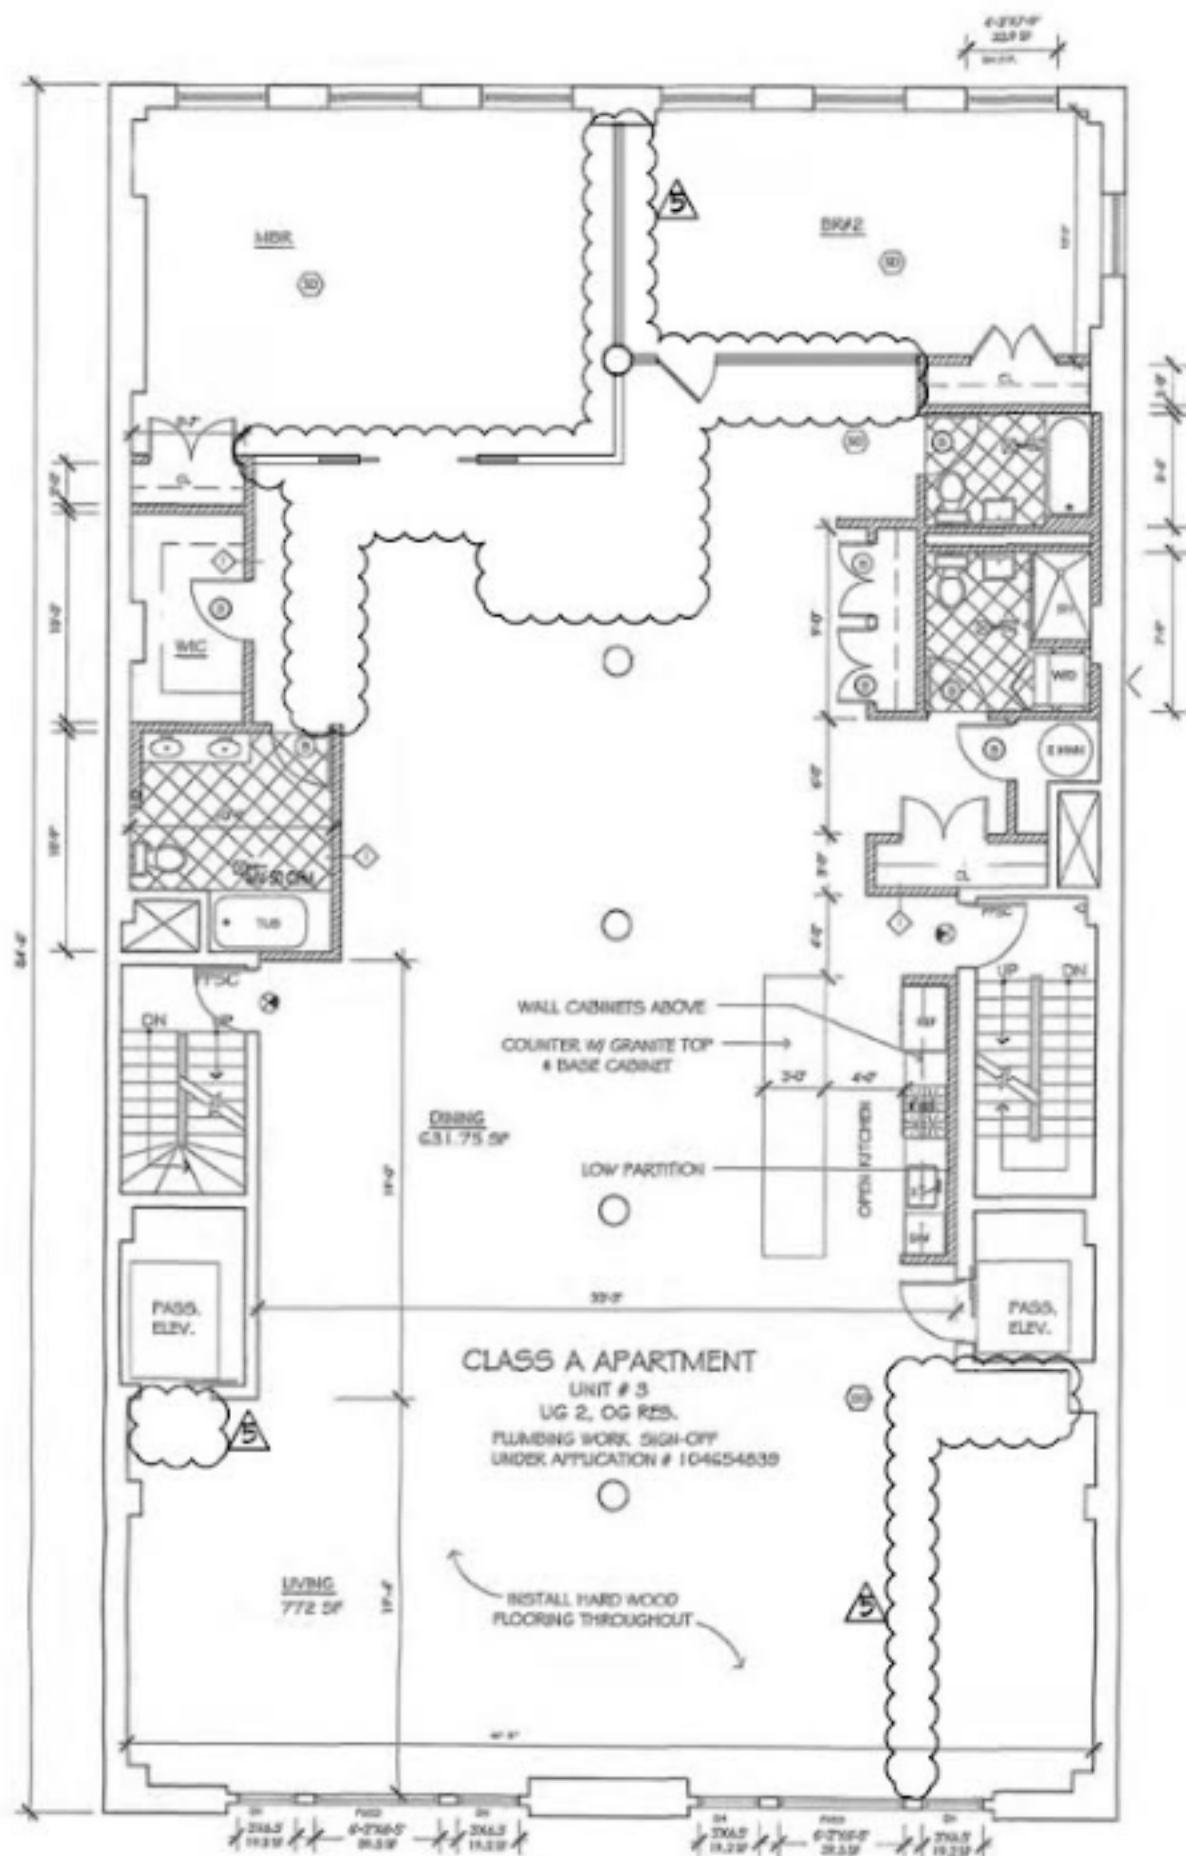

3RD FLOOR PLAN

SCALE: $\frac{1}{8}'' = 1' - 0''$