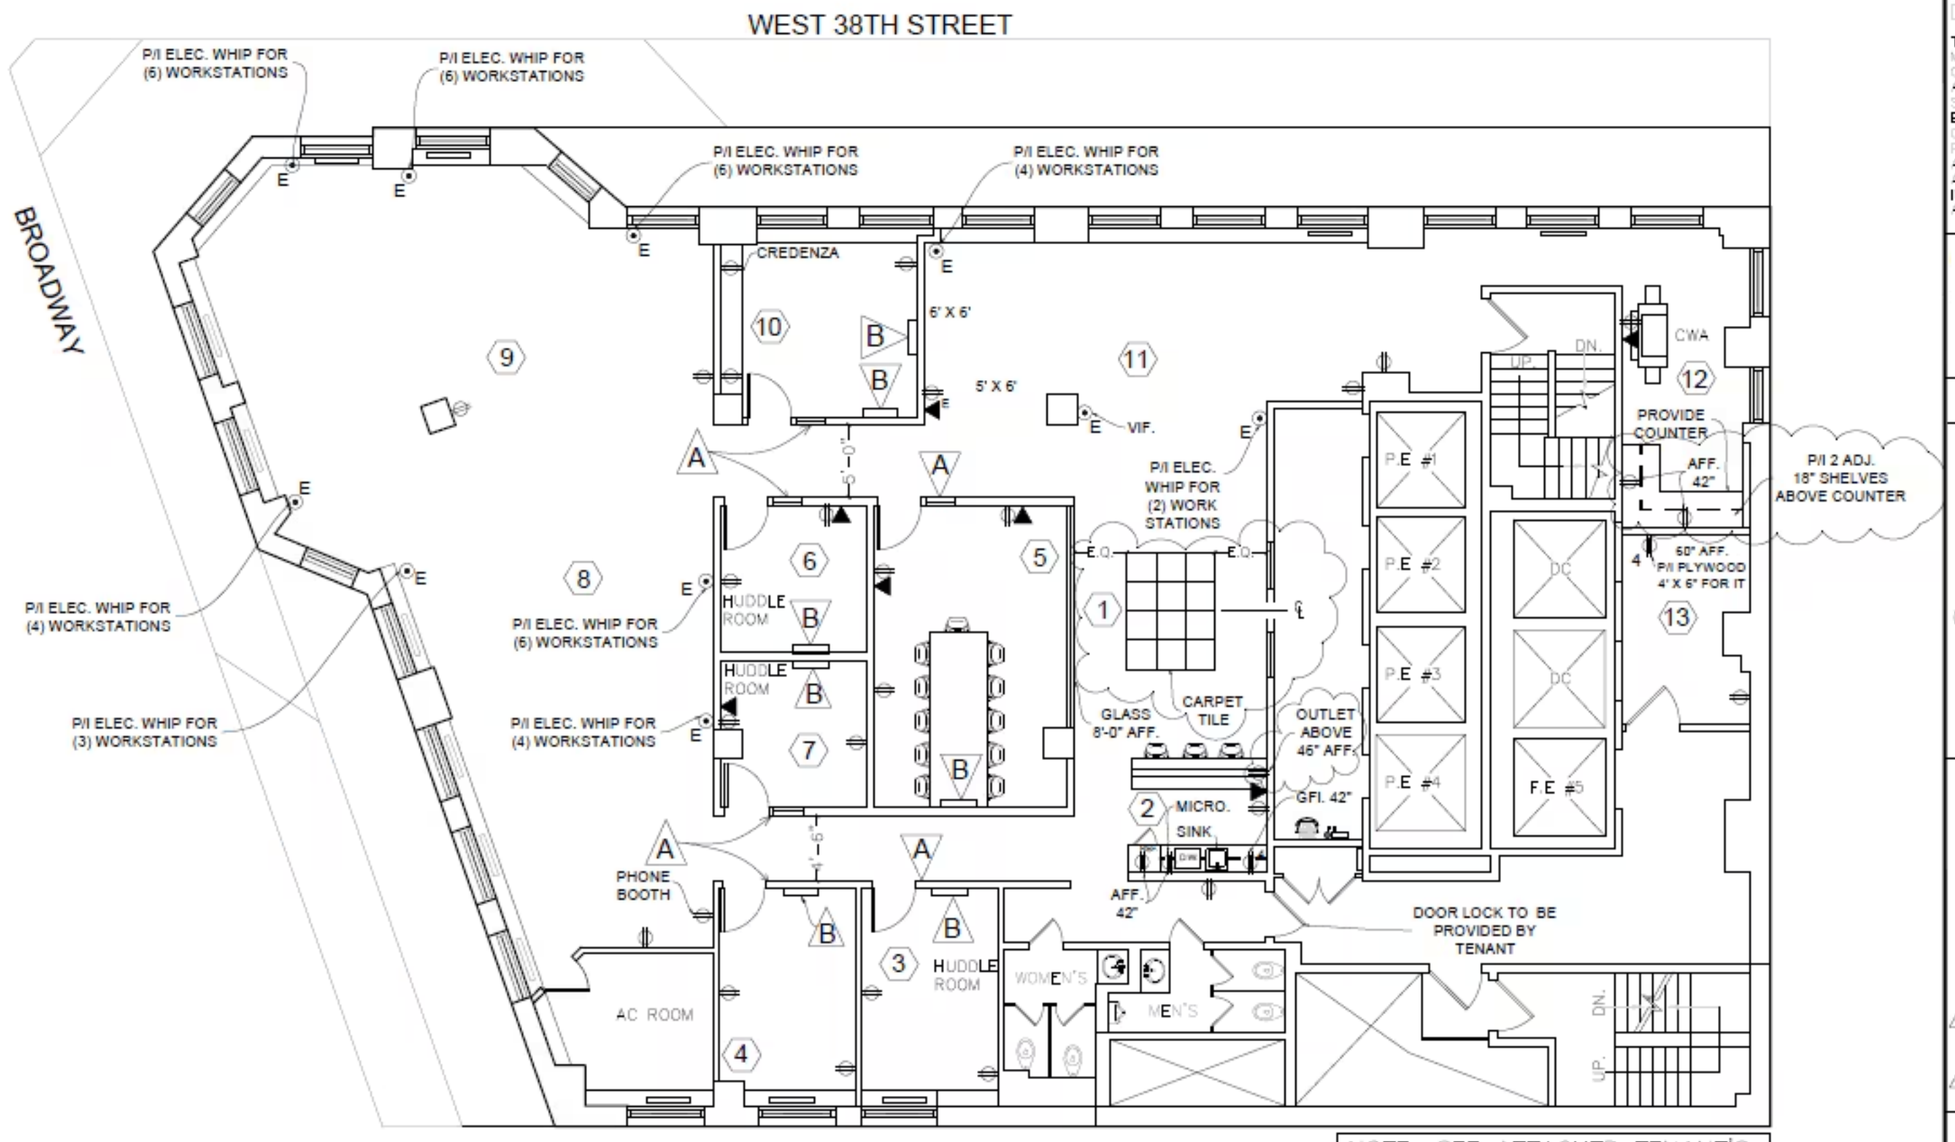

1 / A-2 FURNITURE/POWER PLAN

SCALE: 3/32" = 1'-0"

TENANT INITIAL FOR APPROVAL & DATE

NOTE:

CONTRACTOR SHALL VERIFY ALL FIELD CONDITIONS AND DIMENSIONS AND BE RESPONSIBLE FOR FIELD FIT AND QUANTITY OF WORK.

NO ALLOWANCES SHALL BE MADE ON BEHALF OF THE CONTRACTOR FOR ANY ERROR OR NEGLECT ON HIS PART

DISCLAIMER:

THE ARCHITECTURAL DESIGN WAS BASED UPON AS MUCH OBSERVATIONS, MEASUREMENTS, ETC. AS CIRCUMSTANCES PERMITTED. HOWEVER, THERE WERE ASSUMPTIONS MADE ABOUT UNKNOWN CONDITIONS. SHOULD THE OWNER DECIDE NOT TO UTILIZE GELER ENGINEERING, P.C. TO VERIFY AND INSPECT THESE CONDITIONS IN THE FIELD DURING THE CONSTRUCTION PHASE, GELER ENGINEERING P.C. HIS EMPLOYEES AND CONSULTANTS, WILL NOT BE RESPONSIBLE FOR ANY FAILURE, DAMAGE, INJURY, DELAY, LOSS OF INCOME, EXTRA COST, OR ANY OTHER LOSS DUE TO ANY EXISTING CONDITIONS.

ELECTRICAL PLAN LEGEND

- NEW DUPLEX OUTLET, 18" A.F.F. OR AS NOTED, HORIZONTAL
- NEW DEDICATED CIRCUIT–GFI ALL IN L=KITCHEN & @ 42" AFF.
- TELEPHONE DATA SLEEVE, 18" A.F.F.
- E — P/I ELEC. WHIPS FOR WORKSTATIONS EACH STATION TO HAVE 1 DUPLEX POWER & 1 DATA; QUANTITY AS SHOWN ON PLAN; USE CONNECT TRACT AS NEEDED
- A — SWITCH (DIGIT AFTER INDICATES NUMBER OF SWITCHES)

NOTE:

–DOOR ENTRANCE BUZZER & RELEASE SYSTEM AND OR SECURITY SYSTEM TO BE PROVIDED BY TENANT.
–CONFERENCE ROOMS 10,5 & 4 POWER CONFERENCE ROOM TABLE WITH CONNECT TRACT, VIF TABLE LOCATION PRIOR TO INSTALLING.
–DIGIT AFTER INDICATES NUMBER OF OUTLETS AND/OR DATA SLEEVES.

- A — P/I 1 DATA & 1 DUPLEX OUTLET @ 43" AFF. FOR TABLETS
- B — P/I 1 DATA & 1 DUPLEX @STANDARD HEIGHT ABOVE 1 DATA & 1 DUPLEX @ 60" AFF. FOR T.V.

PROJECT: PARIVEDA SOLUTIONS
1384 BROADWAY
23RD FLOOR
NEW YORK, NY 10018

DRAWING NUMBER/TITLE:	SCALE:
FURNITURE /POWER PLAN	3/32" = 1'-0"
DRAWING DATE: 10/18/2018 REVISED: 01/22/2019	**DRAWING NUMBER:** A-2