
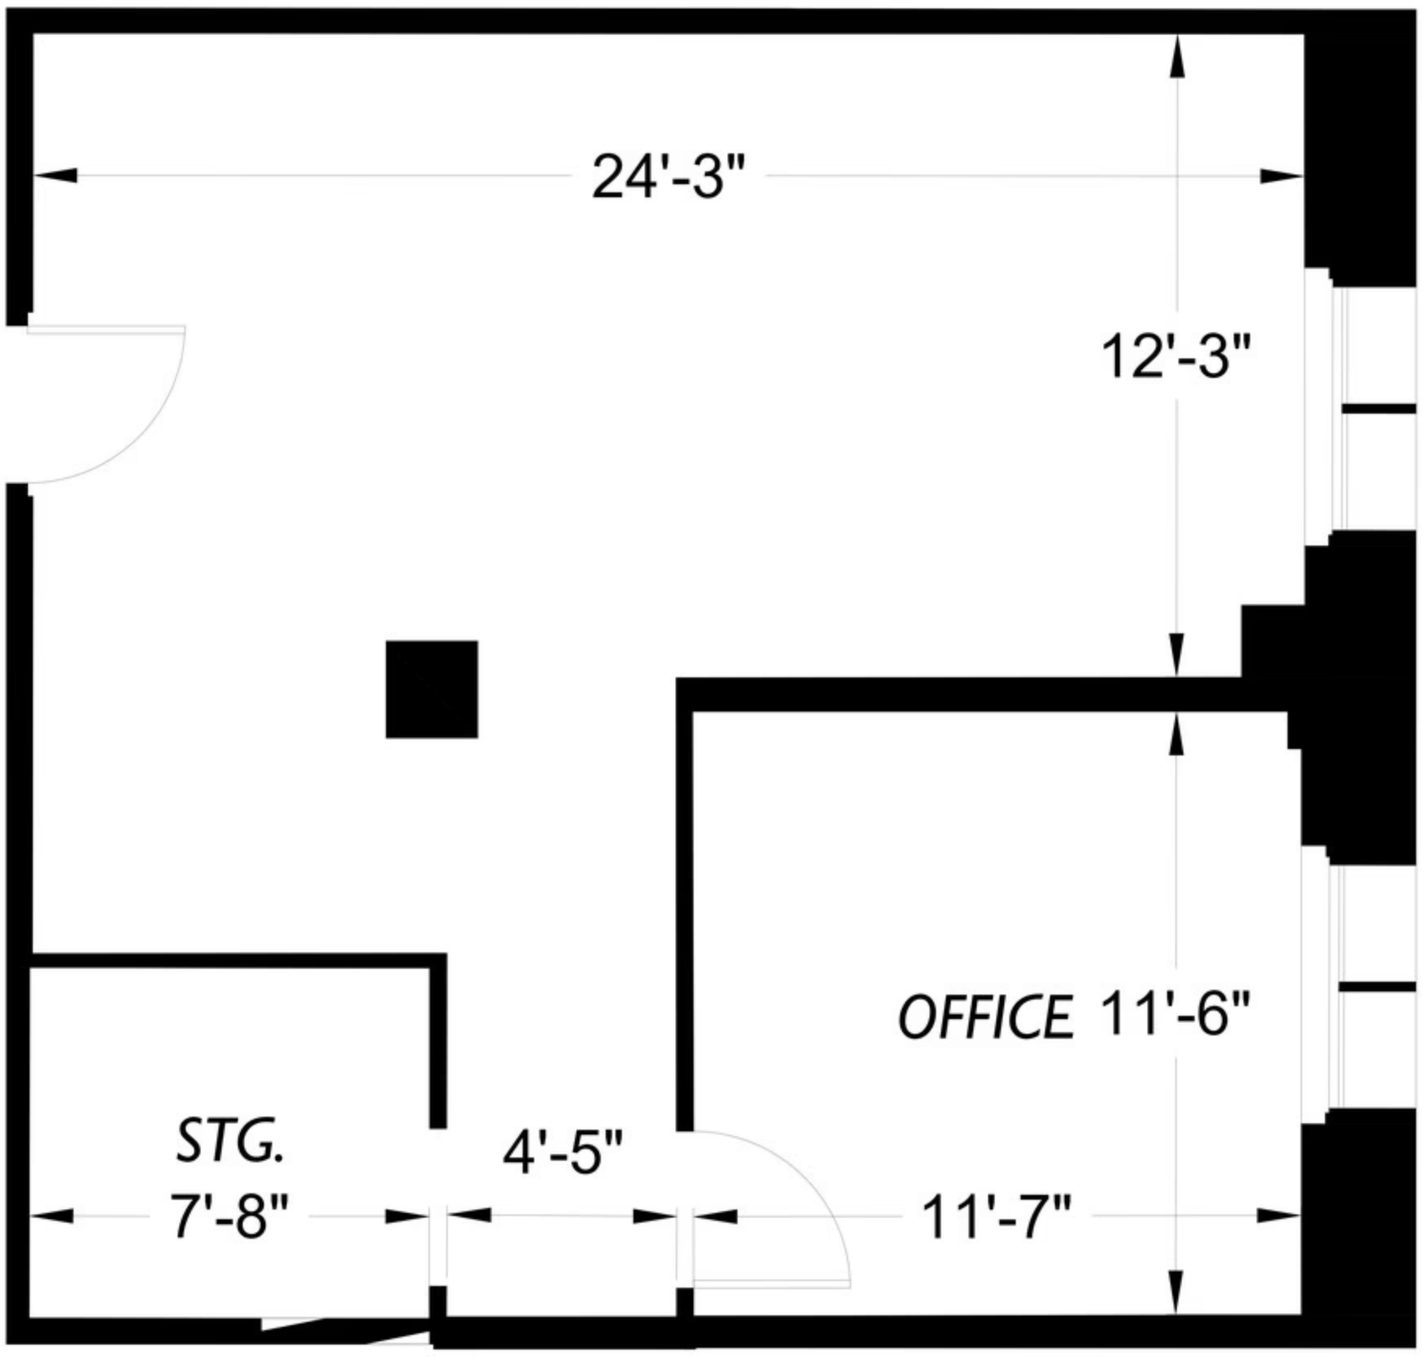


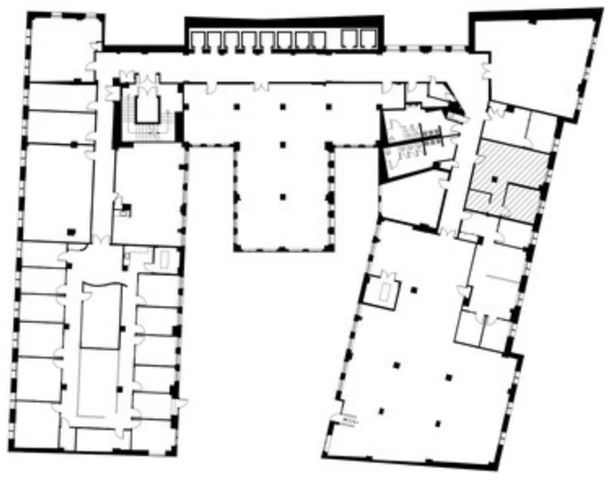

2-D
AS-BUILT
FLOOR PLANS

11 BROADWAY
SUITE 967
NEW YORK, N.Y.